

SURVEY & REMONUMENTATION

AUG 08 1997

COMMISSION

LAND CORNER RECORDATION CERTIFICATE
Filing Requirement of Act 74, Mich. P.A. 1970

Register's Office }
Gogebic County } ss.

Received for record the
11th day of JUNE
A. D. 1997 at 10:35 o'clock
A m., and recorded in
Libor 6 of CORNERS
on page 137

Colleen M. Kibicki, Deputy
Register of Deeds

Register of Deeds Stamp & File Number

For corners in

GOGEBIC
(County)

Located In: Corner Code #

1. Public Land Survey

T49N R48W E-13
T48N R48W E-1

2. Property Controlling in Section

S T R

3. Miscellaneous Property in Sec.

S T R

4. Lot No. _____, Recorded Plat _____

5. Private Claims _____

Section Corner common to Sections 32 & 33, T49N R48W and Sections 4 & 5, T48N R48W.

I, Earl W. Applekamp, in a field survey on May 21, 1997 do hereby state that under requirements of P.A. 74, Michigan P.A. of 1970, the corner points mentioned in lines 1 and 2 above were in conformance with regulations and rules therefore as required in the current manual of survey instructions of the United States Department of the Interior, Bureau of Land Management or by a decree of a Court of Law and/or that the corner points mentioned in lines 3, 4 and 5 above were in conformance with the rules of the Michigan Board of Land Surveyors or by a Decree of a Court of Law; established, re-established, monumented, recovered, found as expressed below:

NOTE: Not more than 2 corners, all in the same town and range, may be recorded on this certificate.

1	A	B	C	D	E	F	G	H	I	J	K	L	M
2		6		5		4		3		2		1	
3													
4		7		8		9		10		11		12	
5													
6		18		17		16		15		14		13	
7													
8		19		20		21		22		23		24	
9													
10		30		29		28		27		26		25	
11													
12		31		32		33		34		35		36	
13													

A. Description of original monument and accessories and/or subsequent restoration:

Original corner established by William A. Burt, U.S. Deputy Surveyor, September 13, 1847. Set Hemlock Post.

ORIGINAL BEARING TREES:

12" Cedar N28°E 15.84 feet
14" Hemlock N07°W 14.52 feet

PEER GROUP APPROVED
Richard P. Deane 6/10/97
COUNTY REPRESENTATIVE

B. Description of corner evidence found and/or method applied in restoring or reestablishing corner:


No original evidence was found. At the apparent corner there was a 1 1/4" drill steel 3 feet above ground with numerous old blazed trees facing this drill steel. Could not find who set this marker. The owner of the property adjacent to the corner said it had been there a good number of years. The position agreed with the G.L.O. calls to creeks and the corner East. I accepted the drill steel as the most logical position for the corner and monumented it as shown in "C".

Research on file with the Gogebic Remonumentation Program Representative.

C. Description of monument for corner and accessories established to perpetuate locating the position of the corner:

At the corner position I set a 2 1/2"X30" aluminum pipe with a 3" cap stamped to read: County Remonumentation, T49N R48W, T49N, T48N, R48W, S32, S33, S4, S5, 1997, P.S. 17610. I established 3 bearing trees and a reference object.

7" Maple N45°W 34.66 feet - 7" Maple S20°W 16.04 feet
8" Black Ash N62°E 45.61 feet - Steel Sign Post West 1.60 feet

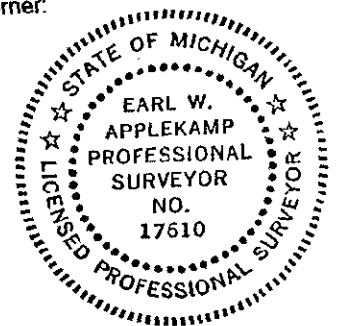

Signed by Earl W. Applekamp
Surveyor's Michigan License No. 17610

Date May 29, 1997