

LAND CORNER RECORDATION CERTIFICATE
Filing Requirement of Act 74, Mich. P.A. 1970

Register's Office }
Gogebic County } ss.

For corners in

<u>Gogebic</u> (County)	Located In:	Corner Code #
1. Public Land Survey	T 48N R 48W	F-5
	T _____ R _____	_____
	T _____ R _____	_____
	T _____ R _____	_____
2. Property Controlling in Section	S _____ T _____ R _____	_____
	S _____ T _____ R _____	_____
3. Miscellaneous Property in Sec.	S _____ T _____ R _____	_____
	S _____ T _____ R _____	_____

Received for record the
21ST day of CORNERS
A. D. 1994 at 11:20 o'clock
A m., and recorded in
Liber 5 of CORNERS
on page 157
Ramona Collins, Deputy
Register of Deeds

Register of Deeds Stamp & File Number

4. Lot No. _____, Recorded Plat _____
5. Private Claims _____

Quarter Corner 9 & 16

	A	B	C	D	E	F	G	H	I	J	K	L	M
2	6	5	4	3	2	1							
3													
4	7	8	9	10	11	12							
5													
6	18	17	16	15	14	13							
7													
8	19	20	21	22	23	24							
9													
10	30	29	28	27	26	25							
11													
12	31	32	33	34	35	36							
13													

I, Richard L. Drahn, in a field survey on October 9, 19 94, do hereby certify that under requirements of P.A. 74, Michigan P.A. of 1970, the corner points mentioned in lines 1 and 2 above were in conformance with regulations and rules therefore as required in the current manual of survey instructions of the United States Department of the Interior, Bureau of Land Management or by a decree of a Court of Law and/or that the corner points mentioned in lines 3, 4 and 5 above were in conformance with the rules of the Michigan Board of Land Surveyors or by a Decree of a Court of Law, established, re-established, monumented, re-monumented, recovered, found as expressed below:

NOTE: Not more than 4 corners, all in the same town and range, may be recorded on this certificate.

A. Description of original monument and accessories and/or subsequent restoration:

Corner established by William Ives, Deputy Surveyor on August 7, 1848
Original bearing trees: Y. Birch 8" N.48 E. 28 links (18.48 Ft.)
Hemlock 8" S.42 W. 10 links (6.60 Ft.)

Corner research form on file at Gogebic County Register of Deeds Office

B. Description of corner evidence found and/or method applied in restoring or reestablishing corner:

Restored corner position at record bearing and distance from the remains of the two original bearing trees. The first a very badly decayed Yellow Birch stump, decayed to below ground level. The second is a windthrown stump hole with decayed hemlock bark and knots. Distance checks to GLO corner 1/2 mile east.


PEER GROUP **Approved**

Richard L. Drahn 10/12/94

C. Description of monument for corner and accessories established to perpetuate locating the position of the corner:

At the corner position I set a 2' by 30" aluminum monument with a 3 1/2" aluminum cap, stamped to read: COUNTY REMONUMENTATION; T.48 N., R.48 W.; 1/4; S. 9, S.16; 1994: R.L.S. 21564. From which I established the following new blazed and scribed bearing trees.

9"	Sugar Maple	S.43 W.	2.78 feet
9"	Sugar Maple	N.71 W.	22.65 feet
13"	Hemlock	N.28 E.	17.17 feet
6'	Steel sign rail	N.50 E.	1.8 feet

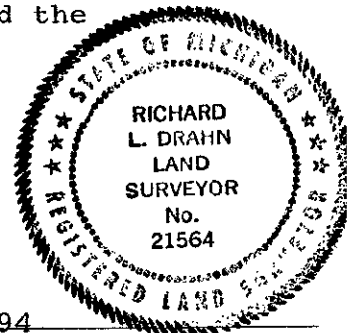

Signed by Richard L. Drahn Date October 9, 1994

Surveyor's Michigan License No. 21564