

LAND CORNER RECORDATION CERTIFICATE
Filing Requirement of Act 74, Mich. P.A. 1970

Register's Office }
 Gogebic County } ss.

For corners in Gogebic
 (County)

1. Public Land Survey Located in: T48NR48W Corner Code # K-3
 T R
 T R
 T R

2. Property Controlling S T R
 in Section S T R

3. Miscellaneous S T R
 Property in Sec. S T R

4. Lot No. , Recorded Plat SECTION

5. Private Claims SECTION

Section Corner common to Sections 1, 2, 11, and 12. T48N, R48W

Received for record the
2ND day of JUNE
 A. D. 2000 at 10:30 o'clock
A m., and recorded in
 Liber 7 of CORNERS
 on page 375
Cheryl Repp, Dep
 Register of Deeds

Register of Deeds Stamp & File
 Number

I, John R. Garske, in a field survey on September, 1998 do hereby state that under requirements of P.A. 74, Michigan P.A. of 1970, the corner points mentioned in lines 1 and 2 above were in conformance with regulations and rules therefore as required in the current manual of survey instructions of the United States Department of the Interior, Bureau of Land Management or by a decree of a Court of Law and / or that the corner points mentioned in lines 3, 4, and 5 above were in conformance with the rules of the Michigan Board of Land Surveyors or by a Decree of a Court of Law; established, re-established, monumented, recovered, found as expressed below.

NOTE: Not more than 2 corners, all in the same town and range, may be recorded on this certificate.

	A	B	C	D	E	F	G	H	I	J	K	L	M
1													
2	6			5			4			3		2	1
3													
4	7			8			9			10		11	12
5													
6	18			17			16			15		14	13
7													
8	19			20			21			22		23	24
9													
10	30			29			28			27		26	25
11													
12	31			32			33			34		35	36
13													

A. Description of original monument and accessories and / or subsequent restoration:

A post set by William Ives, Deputy Surveyor, in August 1848 from which were established the following reference objects:

24" Sugar Maple S 44° E 21 Links
 20" Sugar Maple N 66° W 39 Links

Richard L. Drahn 5/24/00
 COUNTY REGISTER OF DEEDS

B. Description of corner evidence found and / or method applied in restoring or re-establishing corner:

I re-established the Southwest corner of Section 1 at the centerline of Lake Road and online with two wooden posts and an iron pipe South of Lake Road, and a wooden post North of Lake Road (see sketch on back). The posts are on a blue line as marked by the Gogebic County Forestry Department and have been used and accepted for over 30 years. The posts are referenced from a 1930's era survey of Section 1 by the Gogebic County Road Commission by G.W. Koronski, Surveyor.

Record research on file.

C. Description of monument for corner and accessories established to perpetuate locating the position of the corner:


I set a 3/4" x 12" rebar with brass cap as monumenting the section corner position of section 1, 2, 11 and 12, from which I established the following witnesses and reference objects:

Reference monument	North	30.00 feet
8" Yellow birch	N52°W	62.18 feet
12" Maple	S40°W	46.65 feet
10" Maple	S30°E	45.00 feet


Signed by *John R. Garske*

Date 5/24/00

Surveyor's Michigan License No. 28410
 FB # 242, page 131

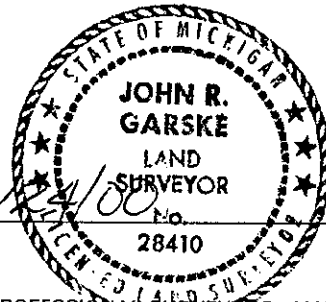

Section Corner common to Sections 1, 2, 11, & 12, ^{K-3}
T 48 N, R 48 W.

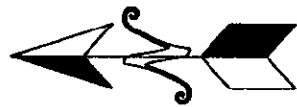

Scale: 1" = 200'

SURVEY &
REMONUMENTATION
JAN 05 2001
SECTION

