
LAND CORNER RECORDATION CERTIFICATE Filing Requirement of Act 74, Mich. P.A. 1970

Reguster's Office Segebic County

For corners in Gogebic (County)	Located in: Corner Code #	Received for record that 2 NO day of June 1. D. 16 00 at 10:20 o'clock
1. Public Land Survey	T48NR48-47W M-2 Τ48NR48-47W A-2 Τ R	A m., and recorded in idea 7 of Corners
2. Property Controlling Sin Section S	T_R SURVEY & T_R #EMONUMENTATION	Register of Doods
3, Miscellaneous S Property in Sec. S	T_R JAN 0 5 2001	Register of Deeds Stamp & File Number

I, John R. Garske, in a field survey on April 24, 2000, do hereby state that under requirements of P.A. 74, Michigan P.A. of 1970, the corner points mentioned in lines 1 and 2 above were in conformance with regulations and rules therefore as required in the current manual of survey instructions of the United States Department of the Interior, Bureau of Land Management or by a decree of a Court of Law and / or that the corner points mentioned in lines 3, 4, and 5 above were in conformance with the rules of the Michigan Board of Land Surveyors or by a Decree of a Court of Law; established, re-established, monumented, recovered, found as expressed below.

NOTE: Not more than 2 corners, all in the same town and range, may be recorded on this certificate.

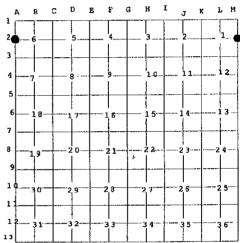

A. Description of original monument and accessories and / or subsequent restoration:

Original survey by William Ives in 1848.******

Original Corner: Cedar post

14" Cedar Original Bearing Trees:

S 30° E

4 Links

16" Cedar

S 12° W

9 Links

B. Description of corner evidence found and / or method applied in restoring or re-establishing corner:

I found a ½" iron rod bent over on the Westerly side of the road at the corner position. This location checks with a single proportic position between the section corners north and south.

Record research on file.

(See sketch on back)


C. Description of monument for corner and accessories established to perpetuate locating the position of the corner:

I accepted the ½" iron rod as monumenting the East quarter corner position of Section 1, T 48 N, R 48 W, and replaced it with a 3-1/4" brass capped 5/8" x 30" rebar set below road grade. I also established the following witnesses:

16" Spruce

S 20° E

162.23 Feet

8" Balsam 7" Black Ash s 87° W N 63° W 32.92 Feet 46.03 Feet

Reference Monument

East

30.00 Feet (Standard aluminum Bersten pige monument)

(Steel sign post set 1.5' East of reference monument)

Signed by

Surveyor's Michigan License No. <u>28410</u> FB # 239, page 175

FORM APPROVED BY MICHIGAN STATE BOARD OF PRO

No 28410

JOHN R. Garske


SURVEYOR

(O**) S**, JAN. 28, 19 AL SHIP LAND BEN SED MAY 14, 19 REVISED JAN. 19:

REVISED OCT., 199

211

Quarter Corner common to Sections 1 & 6, T 48 N, R 47-48 W.

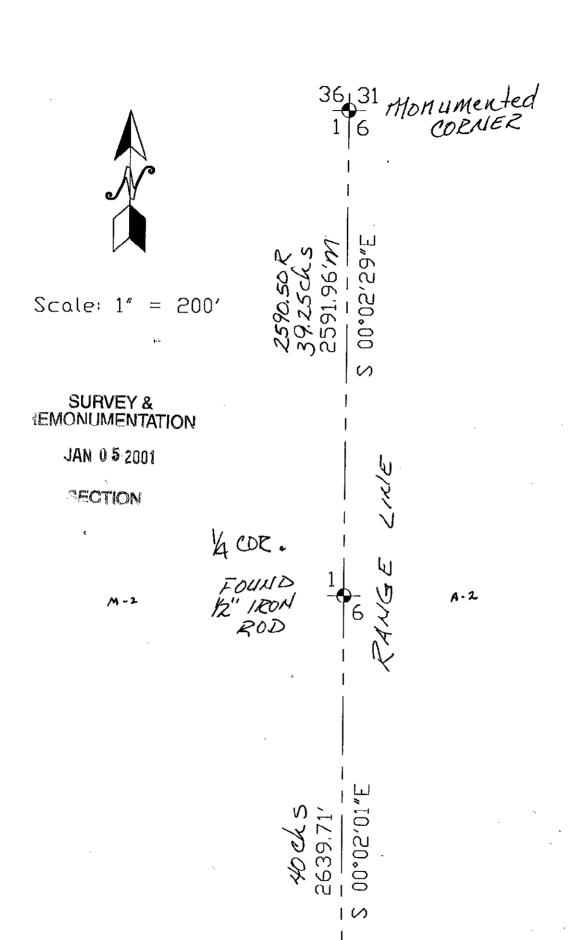

106 COR FROBLITE