


JAN 20 1999

LAND CORNER MONUMENTS

SECTION

T. 48 N., R. 48 W.

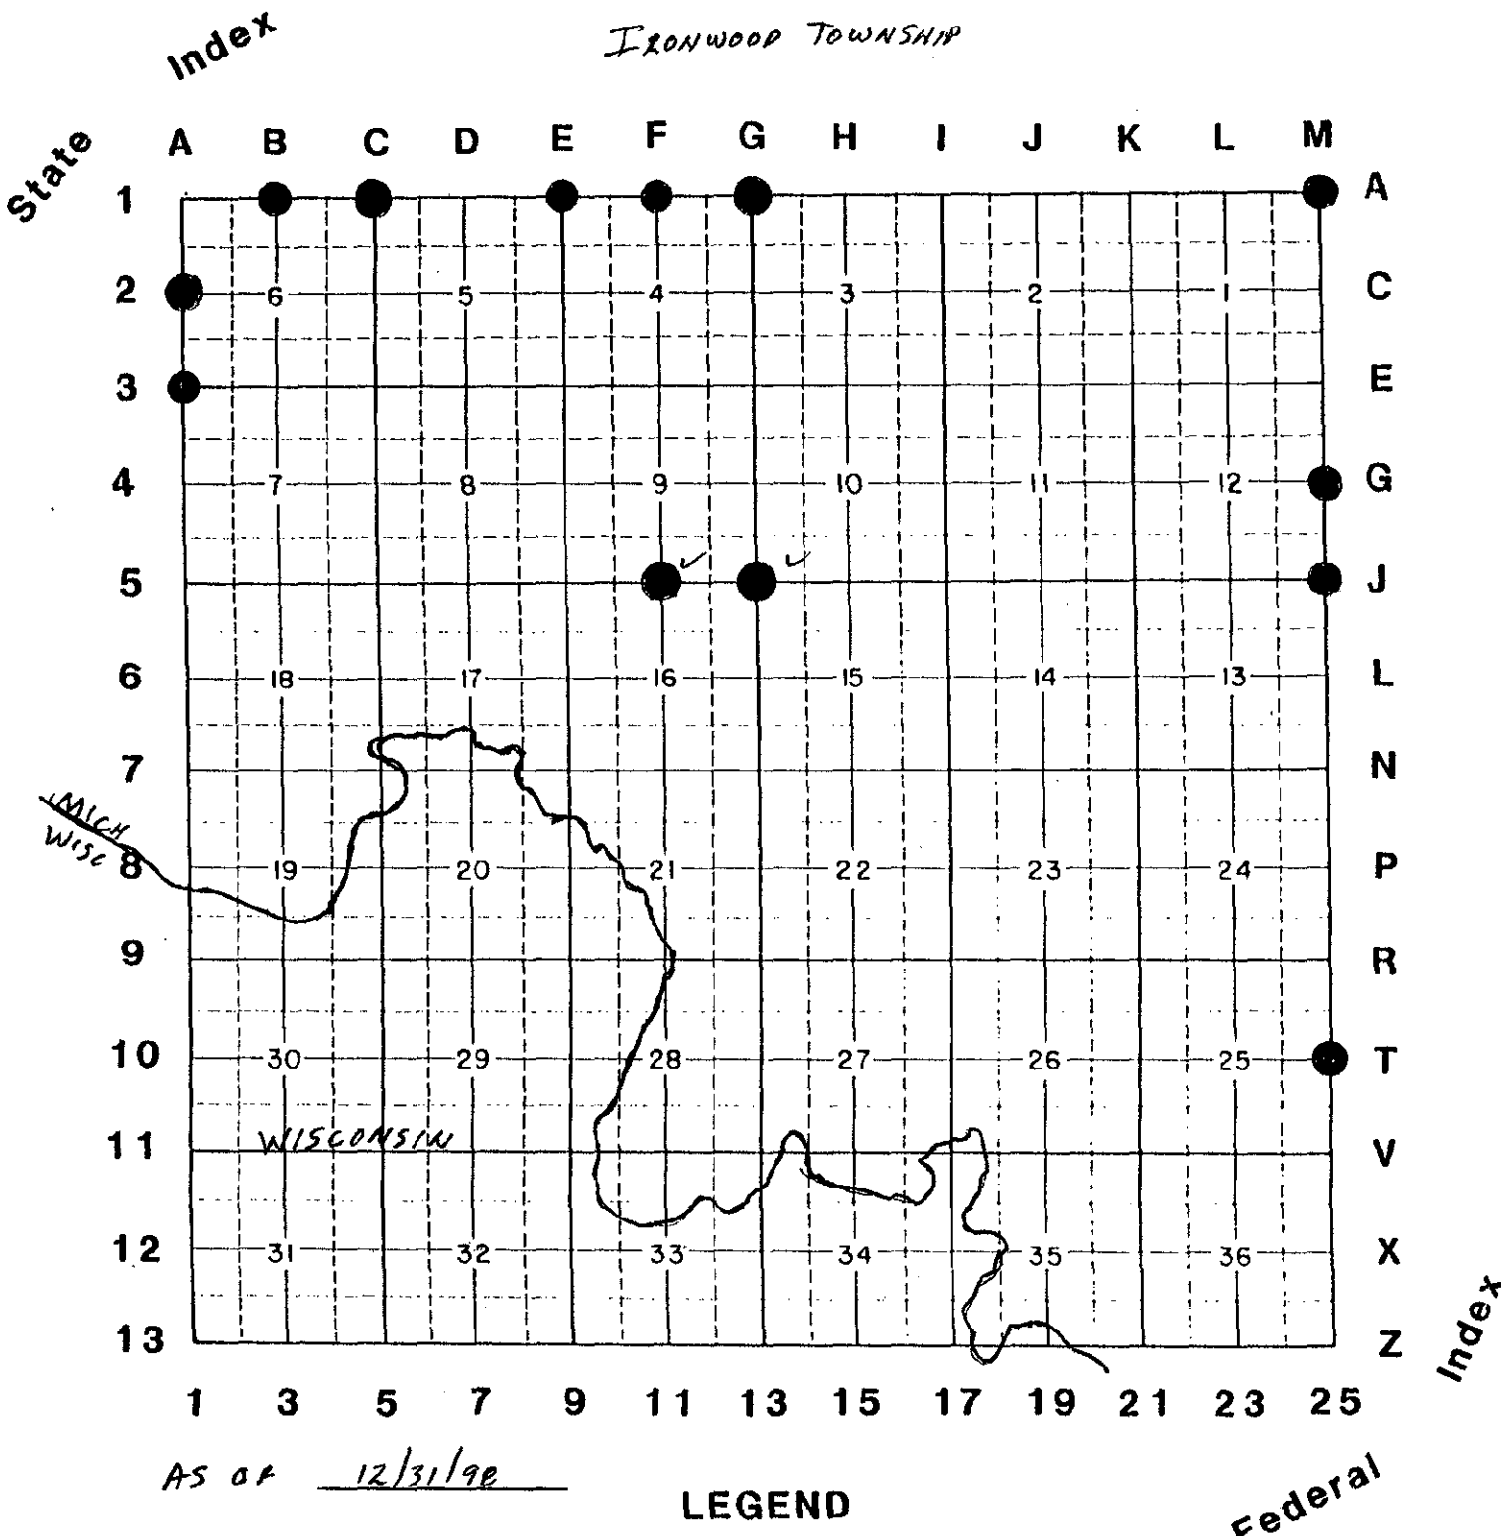

- GLO Corners researched
- ⊙ GLO Corners monumented, not approved
- ⊗ GLO Corners approved
- GLO Corners approved & reported to State