

OCT 03 1996

COMMISSION

LAND CORNER RECORDATION CERTIFICATE
Filing Requirement of Act 74, Mich. P.A. 1970

Register's Office } ss.
Gogebic County }

Received for record the
10th day of JUNE
A. D. 1996 at 9:40 o'clock
A. m., and recorded in
Liber 5 of CORNERS
page 361
Ramona Collins, Deputy
Register of Deeds

For corners in Gogebic (County) Located In: Corner Code #
1. Public Land Survey T 48N R 49W H-5
2. Property Controlling in Section S T R
3. Miscellaneous Property in Sec. S T R
4. Lot No. , Recorded Plat
5. Private Claims

Register of Deeds Stamp & File Number

1/4 Sec. cor. comm. to sec's 10 & 15

I, John P. Goss, in a field survey on May 13, 1996, do hereby certify that under requirements of P.A. 74, Michigan P.A. of 1970, the corner points mentioned in lines 1 and 2 above were in conformance with regulations and rules therefore as required in the current manual of survey instructions of the United States Department of the Interior, Bureau of Land Management or by a decree of a Court of Law and/or that the corner points mentioned in lines 3, 4 and 5 above were in conformance with the rules of the Michigan Board of Land Surveyors or by a Decree of a Court of Law; established, re-established, monumented, re-monumented, recovered, found as expressed below:

Grid table with columns A-M and rows 2-13. A dot is marked at the intersection of column G and row 5.

NOTE: Not more than 4 corners, all in the same town and range, may be recorded on this certificate.

A. Description of original monument and accessories and/or subsequent restoration:

Original corner established by William Ives on August 14, 1848. set post.
Original bearing trees: W. Pine 8" N 26° E 44 links
Aspen 7" S 05° W 23 links.

John Garske found 4" dia. concrete monument with brass table noting monument was set by Gogebic County Park Commission. Garske recorded said corner in Liber 2 on page 262 of Land Corners for Gogebic County. The following reference objects were established: 12" Pine - N 20° E- 15.45'; P.Pole S 53° E- 8.43'

B. Description of corner evidence found and/or method applied in restoring or reestablishing corner:

I found the 4" dia. concrete monument with brass table as noted in John Garske certification and it checked with the witnesses in John Garske certification. I updated the corner monument and accessories as noted below to state and county specification.


Act 74 reseach on file.

PEER GROUP APPROVED
Richard L. Deaton 6/6/96
COUNTY REPRESENTATIVE

C. Description of monument for corner and accessories established to perpetuate locating the position of the corner:

From the monument stated above I established the following bearing trees and reference objects.

- 12" Pine N 20° E 15.45'
P.Pole S 53° E 8.43'
P.Pole S 08° E 35.61'
6"rail and sign N 80°W 1.39'

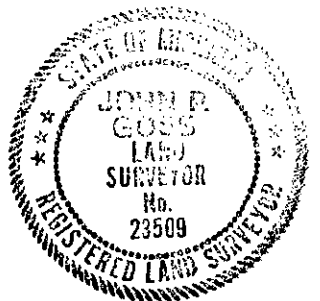

Signed by John P. Goss Date May 14, 1996

Surveyor's Michigan License No. 23509