

SURVEY & REMONUMENTATION

OCT 03 1996

COMMISSION

LAND CORNER RECORDATION CERTIFICATE
Filing Requirement of Act 74, Mich. P.A. 1970

Register's Office }
 Gogebic County } ss.

For corners in Gogebic (County) Located In: _____ Corner Code # _____

1. Public Land Survey	T <u>48N</u> R <u>49W</u>	<u>I-5</u>
	T _____ R _____	_____
	T _____ R _____	_____
	T _____ R _____	_____
2. Property Controlling in Section	S _____ T _____ R _____	_____
	S _____ T _____ R _____	_____
3. Miscellaneous Property in Section	S _____ T _____ R _____	_____
	S _____ T _____ R _____	_____

Received for record the 16th day of August A. D. 1995 at 11:15 o'clock A m., and recorded in Liber 6 of CORNERS on page 30
Ramona Collins, Deputy
 Register of Deeds


Register of Deeds Stamp & File Number

4. Lot No. _____, Recorded Plat _____
 5. Private Claims _____

Section Corner 10,11, 14, & 15, T48N, R49W.

I, John R. Garske, in a field survey on May 16, 1995, do hereby certify that under requirements of P.A. 74, Michigan P.A. of 1970, the corner points mentioned in lines 1 and 2 above were in conformance with regulations and rules therefore as required in the current manual of survey instructions of the United States Department of the Interior, Bureau of Land Management or by a decree of a Court of Law and/or that the corner points mentioned in lines 3, 4 and 5 above were in conformance with the rules of the Michigan Board of Professional Surveyors or by a Decree of a Court of Law; established, re-established, monumented, re-monumented, recovered, found as expressed below:

NOTE: Not more than 4 corners, all in the same town and range, may be recorded on this certificate.

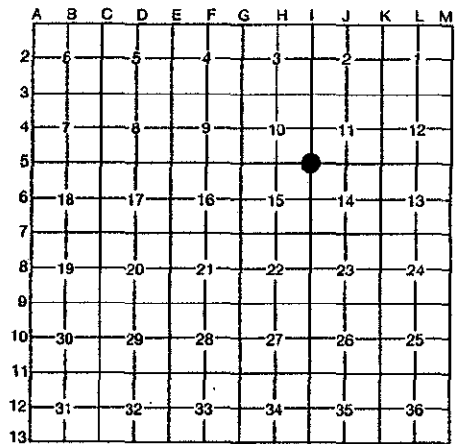

A. Description of original monument and accessories and/or subsequent restoration:

- Original Bearing Trees:
 Hemlock 12"-N40°E-33 links
 Yellow Birch 15"-S-37°W-18 links.
- In 1981 J. Garske RLS 28410 recorded corner, L2, pg. 136, set a 2" x 3' long pipe with a stamped brass cap.
 Ties: 4" maple - N56°W - 28.56 feet
 6" maple - N66°E - 47.30 feet
 8" maple - S29°W - 4.26 feet

B. Description of corner evidence found and/or method applied in restoring or reestablishing corner:


I found the monument as described above with the cap broken off. I checked the monument location and removed the pipe found and reset a new monument as noted below to state and county specifications.

P.A. 74 Research on file.

C. Description of monument for corner and accessories established to perpetuate locating the position of the corner:

I set a 2 1/2' aluminum pipe with 3" diameter aluminum cap stamped: County Remonumentaiton, T48N, R49W, S.10,S.11, S.15, S.14 RLS 28410. The following bearing trees and/or reference objects were established:
 Maple 8"-N56°W-28.27 feet (existing)
 Maple 10"-N66°E-47.06 feet (existing)
 Maple 10"-S29°W-44.00 feet (existing)
 Steel sign post due south 1.06 feet

PEER GROUP APPROVED
Richard P. Dean 08/14/96
 COUNTY REPRESENTATIVE

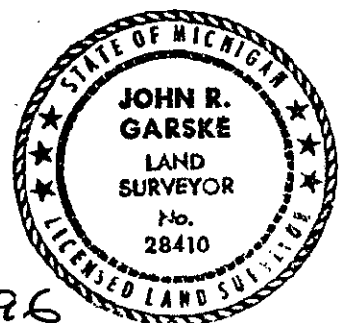

Signed by John R. Garske
 Surveyor's Michigan License No. 28410

Date 8-4-96