

**SURVEY & REMONUMENTATION**

FEB 18 1994

**COMMISSION**

**LAND CORNER RECORDATION CERTIFICATE**  
Filing Requirement of Act 74, Mich. P.A. 1970

Register's Office } ss.  
Gogebic County

Received for record the  
30<sup>th</sup> day of DECEMBER  
A. D. 1993 at 12:30 o'clock  
P M., and recorded in  
Liber 4 of CORNER  
on page 341  
Betty Isaac Deputy  
Register of Deeds

For corners in

Gogebic  
(County)

Located In:

Corner Code #

- |                                    |            |                           |            |
|------------------------------------|------------|---------------------------|------------|
| 1. Public Land Survey              | Section 11 | T <u>48N</u> R <u>49W</u> | <u>K-5</u> |
|                                    |            | T _____ R _____           | _____      |
|                                    |            | T _____ R _____           | _____      |
|                                    |            | T _____ R _____           | _____      |
| 2. Property Controlling in Section | S _____    | T _____ R _____           | _____      |
|                                    | S _____    | T _____ R _____           | _____      |
| 3. Miscellaneous Property in Sec.  | S _____    | T _____ R _____           | _____      |
|                                    | S _____    | T _____ R _____           | _____      |

Register of Deeds Stamp & File Number

4. Lot No. \_\_\_\_\_, Recorded Plat \_\_\_\_\_  
5. Private Claims \_\_\_\_\_

Section corner common to S-11, 12, 13 & 14.

	A	B	C	D	E	F	G	H	I	J	K	L	M
2	6	5	4	3	2								
3													
4	7	8	9	10	11	12							
5													
6	18	17	16	15	14	13							
7													
8	19	20	21	22	23	24							
9													
10	30	29	28	27	26	25							
11													
12	31	32	33	34	35	36							
13													

I, John R. Garske, in a field survey on December 6, 1993, do hereby certify that under requirements of P.A. 74, Michigan P.A. of 1970, the corner points mentioned in lines 1 and 2 above were in conformance with regulations and rules therefore as required in the current manual of survey instructions of the United States Department of the Interior, Bureau of Land Management or by a decree of a Court of Law and/or that the corner points mentioned in lines 3, 4 and 5 above were in conformance with the rules of the Michigan Board of Land Surveyors or by a Decree of a Court of Law; established, re-established, monumented, re-monumented, recovered, found as expressed below:

**NOTE: Not more than 4 corners, all in the same town and range, may be recorded on this certificate.**

A. Description of original monument and accessories and/or subsequent restoration:

Original survey by William Ives, Deputy Surveyor, on August 11, 1848. Set post bearing trees:

- 8" sugar - N15°W - 13 links
- 16" Y. birch - S70°E - 13 links

No original evidence found.


B. Description of corner evidence found and/or method applied in restoring or reestablishing corner:

I reestablished this corner after talking with local long time resident, Earl Jensen and Blaise Erickson, resident and land surveyor. A corner existed in this location many years ago but was destroyed due to road construction. The corner was reestablished by splitting ancient fence lines and setting the corner in the center line intersection of old trails running N-S and E-W. This position was accepted for over 40 years by local residents and the Road Commission. It is consistent with natural feature ties west and south. All other original survey evidence for this corner has been destroyed due to road construction activity.

C. Description of monument for corner and accessories established to perpetuate locating the position of the corner:

Set 3/4" x 30" long rebar with a standard Bernsten 3 1/2" aluminum cap stamped: County Remonumentation; T48N, R49W; S-11; S-12; S-13; S-14; 1993; RLS 28410. Established the following bearing trees and reference objects:

- 3" ash - N09°W - 16.54 feet
- 5" B. ash - S50°E - 36.10 feet
- 4" ash - S15°W - 28.07 feet
- Steel sign post - N73°W - 5.73 feet

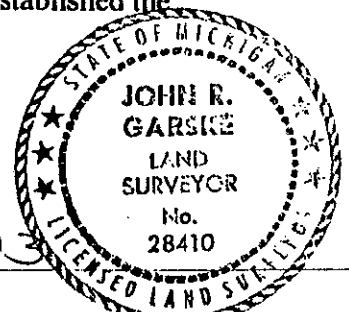

Signed by John R. Garske  
Surveyor's Michigan License No. 28410

Date 12/20/93