

SURVEY & RE-MONUMENTATION

MAY 16 1997

COMMISSION

LAND CORNER RECORDATION CERTIFICATE Register's Office
Gogebic County
Filing Requirement of Act 74, Mich. P.A. 1970

For corners in

Gogebic
(County)

Located In:

Corner Code #

1. Public Land Survey

T49NR 45W	A- 1
T50NR 45W	A- 13
T49NR 46W	M- 1
T50NR 46W	M- 13

2. Property Controlling in Section

S	T	R	
S	T	R	
S	T	R	
S	T	R	

3. Miscellaneous Property in Sec.

4. Lot No. _____, Recorded Plat _____

5. Private Claims _____
Sec. cor. common to sec's. 31, 36, 6 & 1


I, John P. Goss, in a field survey on Oct. 16, 1996 do hereby state that under requirements of P.A. 74, Michigan P.A. of 1970, the corner points mentioned in lines 1 and 2 above were in conformance with regulations and rules therefore as required in the current manual of survey instructions of the United States Department of the Interior, Bureau of Land Management or by a decree of a Court of Law and/or that the corner points mentioned in lines 3, 4 and 5 above were in conformance with the rules of the Michigan Board of Land Surveyors or by a Decree of a Court of Law; established, re-established, monumented, recovered, found as expressed below:

NOTE: Not more than 2 corners, all in the same town and range, may be recorded on this certificate.

Received for record on
12th day of DECEMBER
A. D. 1996 at 2:30 o'clock
1st m., and recorded in
Liber 6 of CORNERS
on page 90

Raymond L. Collins, Deputy
Register of Deeds

Register of Deeds Stamp & File Number

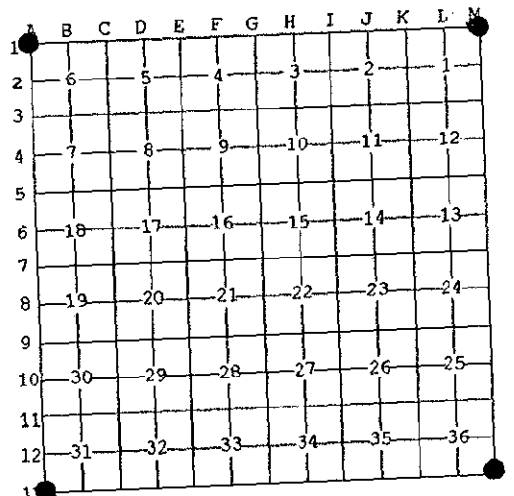

A. Description of original monument and accessories and/or subsequent restoration:

Original corner established by Austin Burt in Sept. 1847. Set Cedar post.
Original bearing trees: Hemlock 14" S 48° E 40 links
Ash 12" N 51° W 52 links

On July 31, 1980, Keith Sackett, RLS for DNR found a 2" I.D. iron pipe marked T.49-50 N., R.45-46 W., TWN., 31,36,6 & 1, 1959. He accepted said corner and recorded it in Liber 2, page 124 of Land Corners for Gogebic County. He established the following bearing trees and reference objects: 8" Ash- S 66° W- 23.7, S-1, NBT; 2" W. Birch- S 78° E- 22.6', S-6, NBT; 5" Maple- N 29° W- 29.7, S-36, NBT.

B. Description of corner evidence found and/or method applied in restoring or reestablishing corner:
I found the 2" I.D. iron pipe with cap marked T. 49-50 N., R.45-46 W., TWN; 31,36,6, & 1; 1959. It checked with Keith Sackett witnesses. I updated the accessories as noted below to state and county specification.

Act 74 research on file.

PEER GROUP APPROVED
Richard R. Deahn 12/11/96
COUNTY REGISTER

C. Description of monument for corner and accessories established to perpetuate locating the position of the corner:
From the 2" I.D. iron pipe with cap marked T.49-50 N., R.45-46 W., TWN; 31,36,6, & 1; 1959. I established the existing and new bearing trees and reference objects.

10" Ash	S 66° W	24.34'	S-1, NBT
5" W. Birch	S 78° E	22.83'	S-6, NBT
9" Maple	N 29° W	30.00'	S-36, NBT
8" Maple	N 16° E	33.37'	
6' Rail & Sign	North	1.31'	

Measurements to trees are to nail in side of tree.

Signed by John P. Goss
Surveyor's Michigan License No. 23509
Fed. No. Z-1

Date Oct 17, 1996

