

MAR 02 2000

SECTION

LAND CORNER RECORDATION CERTIFICATE
Filing Requirement of Act 74, Mich. P.A. 1970

Register's office }
Gogebic County } SA.

Received for record the
26TH day of AUGUST
A. D. 1999 at 1:40 o'clock
P m., and recorded in
Liber 7 of CORNERS
on page 230

Nanana Collins Deputy
Register of Deeds

For corners in

<u>Gogebic</u> (County)	Located in:	Corner Code #
1. Public Land Survey	T <u>48N</u> R <u>45W</u>	<u>B-1</u>
	T <u> </u> R <u> </u>	<u> </u>
	T <u> </u> R <u> </u>	<u> </u>
	T <u>49N</u> R <u>45W</u>	<u>B-13</u>
2. Property Controlling in Section	S <u> </u> T <u> </u> R <u> </u>	<u> </u>
	S <u> </u> T <u> </u> R <u> </u>	<u> </u>
3. Miscellaneous Property in Sec.	S <u> </u> T <u> </u> R <u> </u>	<u> </u>
	S <u> </u> T <u> </u> R <u> </u>	<u> </u>


Register of Deeds Stamp & File Number

4. Lot No. _____, Recorded Plat _____
5. Private Claims _____

Quarter corner 6 & 31; T.48-49 N., R.45 W.

I, Richard L. Drahn, in a field survey on August 2, 1999 do hereby state that under requirements of P.A. 74, Michigan P.A. of 1970, the corner points mentioned in lines 1 and 2 above were in conformance with regulations and rules therefore as required in the current manual of survey instructions of the United States Department of the Interior, Bureau of Land Management or by a decree of a Court of Law and /or that the corner points mentioned in lines 3, 4 and 5 above were in conformance with the rules of the Michigan Board of Land Surveyors or by a Decree of a Court of Law; established, re-established, monumented, recovered, found as expressed below:

NOTE: Not more than 2 corners, all in the same town and range, may be recorded on this certificate.

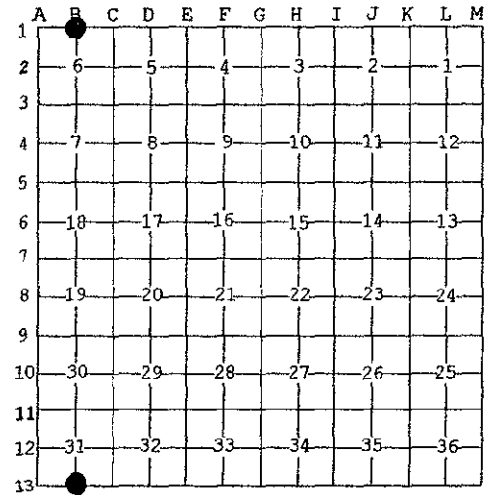

A. Description of original monument and accessories and/or subsequent restoration:

Original corner established by Austin Burt on 9/9/1847. Original bearing trees:

Tamarack	14"	N.31° W.	35 links	(23.10')
Fir	6"	N.59° E.	13 links	(8.58')

Tamarack B.T. recovered scribed by Mark Bale, Gogebic County Forester, on 7/11/90.

B. Description of corner evidence found and/or method applied in restoring or reestablishing corner:

Restored the corner position at record bearing and distance from the original Tamarack bearing tree. It is now an 18" Tamarack pikepole with all scribing and the top half of the measuring notch still visible. No evidence remains of the original Fir B.T.

Corner research on file with Gogebic County records.

C. Description of monument for corner and accessories established to perpetuate locating the position of the corner:

At the corner position I set a 3/4" X 8" aluminum rod monument with a 3 1/4" stamped aluminum cap and the following new B.T.s (all measurements taken to a nail in side of tree)

Cedar	10"	N.26° W.	24.29'
Cedar	8"	N.58° E.	28.32'
Cedar	12"	S.01° W.	13.71'
Steel sign rail	6"	S.88° E.	2.31'

DEED GROUP APPROVED

Richard L. Drahn 8/24/99
COUNTY REPRESENTATIVE



Signed by Richard L. Drahn Date August 10, 1999

Surveyor's Michigan License No. 21564

FORM APPROVED BY MICHIGAN STATE BOARD OF PROFESSIONAL SURVEYORS, JAN. 28, 1971
REVISED MAY 14, 1975
REVISED JAN., 1983
REVISED OCT., 1985