

**SURVEY & MONUMENTATION**

JAN 05 2001

**SECTION**

**LAND CORNER RECORDATION CERTIFICATE**  
Filing Requirement of Act 74, Mich. P.A. 1970

For corners in

Gogebic Located In: Corner Code #  
(County)

1. Public Land Survey T 48N 45W C-1  
T \_\_\_ R \_\_\_  
T \_\_\_ R \_\_\_  
T 49N 45W C-13

2. Property Controlling in Section S \_\_\_ T \_\_\_ R \_\_\_  
S \_\_\_ T \_\_\_ R \_\_\_

3. Miscellaneous Property in Sec. S \_\_\_ T \_\_\_ R \_\_\_  
S \_\_\_ T \_\_\_ R \_\_\_

Register's Office } ss.  
Gogebic County }

Received for record the  
25<sup>th</sup> day of August  
A. D. 1900 at 1:20 o'clock  
P m., and recorded in  
8 of CORNER  
on page 17  
Ramona Collins Deputy  
Register of Deeds

Register of Deeds Stamp & File Number

4. Lot No. \_\_\_\_\_, Recorded Plat \_\_\_\_\_  
5. Private Claims \_\_\_\_\_

Section Corner 5, 6, 31 & 32; T 48-49 N., R. 45 W.

I, Richard L. Drahn in a field survey on Aug. 16, 1900 do hereby state that under requirements of P.A. 74, Michigan P.A. of 1970, the corner points mentioned in lines 1 and 2 above were in conformance with regulations and rules therefore as required in the current manual of survey instructions of the United States Department of the Interior, Bureau of Land Management or by a decree of a Court of Law and /or that the corner points mentioned in lines 3, 4 and 5 above were in conformance with the rules of the Michigan Board of Land Surveyors or by a Decree of a Court of Law; established, re-established, monumented, recovered, found as expressed below:

1	A	B	C	D	E	F	G	H	I	J	K	L	M
2		6	5		4		3		2		1		
3													
4		7	8		9		10		11		12		
5													
6		18	17		16		15		14		13		
7													
8		19	20		21		22		23		24		
9													
10		30	29		28		27		26		25		
11													
12		31	32		33		34		35		36		
13													


NOTE: Not more than 2 corners, all in the same town and range, may be recorded on this certificate.

A. Description of original monument and accessories and/or subsequent restoration:  
Original corner established by Austin Burt on 9/9/1847. Original B.T.s:  
Sugar 10" N.64 E. 38 links (25.08')  
Y. Birch 18" N.21 W. 52 links (34.32')

B. Description of corner evidence found and/or method applied in restoring or reestablishing corner:  
I restored the corner position at record bearing and distance from the wind-thrown stump holes of the two original bearing trees. Distances east, west and south ½ mile to recovered corners is in accord with the field notes of the original Government survey.  
A 1 ¼" iron pipe, source unknown bears S.87 W., 9.0' from the original corner location.  
Corner research on file with Gogebic County records.

C. Description of monument for corner and accessories established to perpetuate locating the position of the corner:  
At the corner position I set a 2" X30" aluminum pipe with a 3 ¼" stamp aluminum cap and the following new bearing trees:  
Yellow Birch 12" East 2.58'  
Yellow Birch 8" S.67 W. 29.36'  
Sugar Maple 8" N.14 W. 15.62'  
Steel sign rail 6' S.36 W. 1.98'

PEER GROUP APPROVED  
Richard L. Drahn 8/23/00  
COUNTY REGISTER

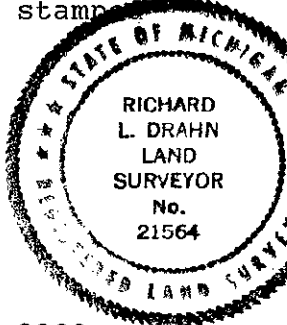

Signed by Richard L. Drahn Date August 17, 2000  
Surveyor's Michigan License No. 21564