

**SURVEY &
MONUMENTATION**

JAN 05 2001

LAND CORNER RECORDATION CERTIFICATE
Filing Requirement of Act 74, Mich. P.A. 1970

Register's Office }
Gogebic County } ss.

SECTION

For corners in

<u>Gogebic</u> (County)	Located In:	Corner Code #
1. Public Land Survey	T48NR 45W	E-1
	T R	
	T R	
	T49NR 45W	E-13
2. Property Controlling in Section	S T R	
	S T R	
3. Miscellaneous Property in Sec.	S T R	
	S T R	

Received for record the
25th day of August
A. D. 1900 at 1:20 o'clock
PM, and recorded in
Liber 8 of CORNERS
on page 22
Bernice Collins DePitt
Register of Deeds

Register of Deeds Stamp & File Number

4. Lot No. _____, Recorded Plat _____
5. Private Claims _____

Section Corner 4, 5, 32 & 33; T.48-49 N., R.45 W.

I, Richard L. Drahn a field survey on Aug. 16, 1900 do hereby state that under requirements of P.A. 74, Michigan P.A. of 1970, the corner points mentioned in lines 1 and 2 above were in conformance with regulations and rules therefore as required in the current manual of survey instructions of the United States Department of the Interior, Bureau of Land Management or by a decree of a Court of Law and/or that the corner points mentioned in lines 3, 4 and 5 above were in conformance with the rules of the Michigan Board of Land Surveyors or by a Decree of a Court of Law; established, re-established, monumented, recovered, found as expressed below:

A	B	C	D	E	F	G	H	I	J	K	L	M
1				●								
2	6		5		4		3		2		1	
3												
4	7		8		9		10		11		12	
5												
6	18		17		16		15		14		13	
7												
8	19		20		21		22		23		24	
9												
10	30		29		28		27		26		25	
11												
12	31		32		33		34		35		36	
13				●								

NOTE: Not more than 2 corners, all in the same town and range, may be recorded on this certificate.

A. Description of original monument and accessories and/or subsequent restoration:

Original corner established by Austin Burt on 9/9/1847. Original B.T.s:
Sugar 9" N.21 E. 32 links (21.12')
Sugar 12" N.27 W. 36 links (23.76')

B. Description of corner evidence found and/or method applied in restoring or reestablishing corner:


I restored the corner position at record bearing and distance from the stump holes of the two original bearing trees. The 2.00 chain distance west to "Ascend ledge, 20 ft., WSW" and the 40.00 chain distance east and west to recovered quarter corners is in accord with the field notes of the original Government survey. A downed 6" Sugar Maple, squared and painted for the corner bears S.85 E., 6.0 ft. from the original corner location.

Corner research on file with Gogebic County records.

C. Description of monument for corner and accessories established to perpetuate locating the position of the corner:

At the corner position I set a 2" X 30" aluminum pipe with a 3 1/4" aluminum cap and the following new bearing trees:

Sugar Maple	6"	N.27 W.	27.15'
Sugar Maple	9"	S.52 E.	23.37'
Sugar Maple	4"	S.48 W.	17.36'
Steel sign rail	6'	N.58 E.	2.08'

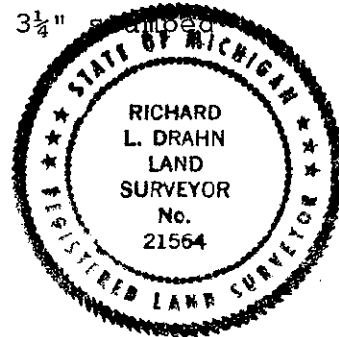

BEER GROUP APPROVED
Richard L. Drahn 8/23/00
COUNTY DEPARTMENT

Signed by Richard L. Drahn
Surveyor's Michigan License No. 21564

Date August 17, 2000