

SURVEY & REMONUMENTATION

AUG 08 1997

COMMISSION

LAND CORNER RECORDATION CERTIFICATE
Filing Requirement of Act 74, Mich. P.A. 1970

Register's Office } ss.
Gogebic County }

For corners in

Gogebic
(County)

Located In: Corner Code #

1. Public Land Survey

T 49NR 46W A 49
T 49NR 47W M 49
T ___ R ___
T ___ R ___
S ___ T ___ R ___
S ___ T ___ R ___
S ___ T ___ R ___
S ___ T ___ R ___

2. Property Controlling in Section

3. Miscellaneous Property in Sec.

4. Lot No. _____, Recorded Plat _____

5. Private Claims _____

Section Corner to 24,25,19 & 30, T49N, R47-46W

I, John R. Garske, in a field survey on May 9, 19 97 do hereby state that under requirements of P.A. 74, Michigan P.A. of 1970, the corner points mentioned in lines 1 and 2 above were in conformance with regulations and rules therefore as required in the current manual of survey instructions of the United States Department of the Interior, Bureau of Land Management or by a decree of a Court of Law and /or that the corner points mentioned in lines 3, 4 and 5 above were in conformance with the rules of the Michigan Board of Land Surveyors or by a Decree of a Court of Law; established, re-established, monumented, recovered, found as expressed below:

NOTE: Not more than 2 corners, all in the same town and range, may be recorded on this certificate.

A. Description of original monument and accessories and/or subsequent restoration:

Original Survey by John & William Burt, Deputy surveyors in 1847. Original corner was a wood post.
Original bearing trees:
Yellow Birch - 28" - N62° W - 25lks (16.50')
Fir - 10" - N40°E - 15 lks (9.90')


B. Description of corner evidence found and/or method applied in restoring or reestablishing corner:

I restored the corner position from the decayed remains of the yellow birch bearing tree decayed to ground level. Retracement measurements south 287' puts us at a creek (29GLO). However an old creek bed can be seen at the GLO distance. The creeks location could easily have changed as a trail with a log culvert crosses the creek 150' upstream. Mr Albert LaGrew, a long time resident remembers a post marking the corner position with a blazed hemlock facing the post, dated 1929. This hemlock now 20" dia. still stands facing our position. Writing on the inside blaze notes corner N.E.-19', which checks with my location. A Keweenaw tag is on the west side of a 24' S. Maple 5 feet due south of my position. Retracement measurements north and east check with this location.

C. Description of monument for corner and accessories established to perpetuate locating the position of the corner:

I set a 3/4" dia. x 4' long aluminum rod with a 3 1/4' stamped aluminum cap from which:
- 6" S. Maple - S43°E - 21.45 feet
- 6" S. Maple - N12°W - 15.99 feet
- 6" Y. Birch - N67°W - 38.96 feet
- Steel Sign Post - N65°E - 2.50 feet
- 20" Hemlock - S65°W - 18.20 feet

PEER GROUP APPROVED
Richard L. Drach 6/10/97
COURT REPRESENTATIVE

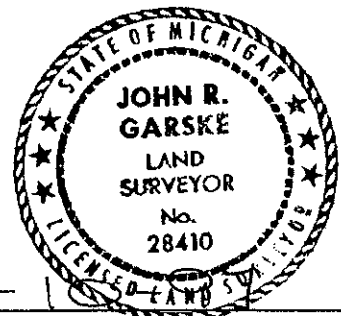

Signed by John R. Garske
Surveyor's Michigan License No. 28410

Date 6-10-97

Received for record the
11TH day of JUNE
A. D. 1997 at 10:35 o'clock
P m., and recorded in
Liber 6 of CORNERS
on page 135
Colleen M. Kitch, Deputy
Register of Deeds

Register of Deeds Stamp & File Number

	A	B	C	D	E	F	G	H	I	J	K	L	M
1													
2	6		5		4		3		2		1		
3													
4	7		8		9		10		11		12		
5													
6	18		17		16		15		14		13		
7													
8	19		20		21		22		23		24		
9													
10	30		29		28		27		26		25		
11													
12	31		32		33		34		35		36		
13													