

SURVEY &
REMONUMENTATION

SEP 08 1998

SECTION

LAND CORNER RECORDATION CERTIFICATE
Filing Requirement of Act 74, Mich. P.A. 1970

Register's Office }
Gogebic County } 33.

For corners in

Gogebic

(County)

Located In:

Corner Code #

1. Public Land Survey

T49N R46W G-4

T ___ R ___

T ___ R ___

T ___ R ___

2. Property Controlling
in Section

S ___ T ___ R ___

S ___ T ___ R ___

3. Miscellaneous
Property in Sec.

S ___ T ___ R ___

S ___ T ___ R ___

4. Lot No. _____, Recorded Plat _____

5. Private Claims _____

1/4 corner comm. to sec's. 9 & 10, T49N, R46W

I, John P. Goss, in a field survey on April, 16, 1998 hereby state that under requirements of P.A. 74, Michigan P.A. of 1970, the corner points mentioned in lines 1 and 2 above were in conformance with regulations and rules therefore as required in the current manual of survey instructions of the United States Department of the Interior, Bureau of Land Management or by a decree of a Court of Law and for that the corner points mentioned in lines 3, 4 and 5 above were in conformance with the rules of the Michigan Board of Land Surveyors or by a Decree of a Court of Law, established, re-established, monumented, recovered, found as expressed below:

NOTE: Not more than 2 corners, all in the same town and range, may be recorded on this certificate.

A. Description of original monument and accessories and/or subsequent restoration:
Corner established by William Burt, in 1848.

Original bearing trees: Hemlock 22" N 40° E 31 links
Hemlock 22" S 80° W 14 links

Donald D. Lappala, on April 22, 1966, restored corner position at record bearing and distance from the decayed remains of the two original bearing trees. The restored GLO corner position is located N 35° 44' 44" W, a distance of 2.24 feet from a mathematical single proportional evaluation of the section line between sections 9 & 10. He set a 2" I.D. iron pipe with 3" circular bronze cap, stamped to indicated the corner position. He established the following reference objects.

B. Description of corner evidence found and/or method applied in restoring or reestablishing corner:
10" Cedar - N 28° W - 43.6'; 6" Yellow Birch - N 25° E - 31.7'
4" Yellow Birch - N 72° E - 17.3' (Now a stub)

A 4" dia. concrete filled, iron pipe monument bearing N 09° E, 19.45 feet.
He recorded said corner in liber 1, page 299 of Land Corners for Gogebic County, Found Donald D. Lappala, corner and witnesses.
I updated the corner monument and accessories as noted below to state and county specification.


Act 74 research on file.

C. Description of monument for corner and accessories established to perpetuate locating the position of the corner:
From the found 2" I.D. iron pipe with 3" Circular bronze cap which reads: T.49N., R.46 W.: 1/4; S-9, S-10; R.L.S. 12585; 1966. I established existing and new reference objects.

12" Cedar N 28° W 43.65'
11" White Birch N 25° E 31.66'
6" Maple S 45° E 11.55'
6' Rail & sign S 77° W 1.62' (to face)
(All measurement taken to nail in side of tree)

SEEK GROUP APPROVAL

Richard P. Drah 5/13/98
COUNTY PARASURVEYOR

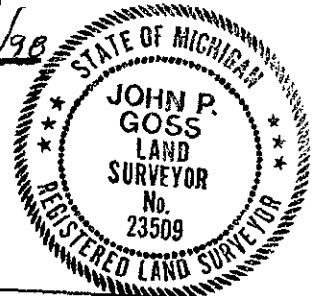

Signed by John P. Goss

Surveyor's Michigan License No. 23509

Date April 17, 1998

Fed. No. G-13

Register of Deeds Stamp & File Number

Received for record the
14th day of MAY
A. D. 1998 at 3:30 o'clock
P m., and recorded in
Liber 6 of CORNERS
on page 397
Ramona Collins, Dep.
Register of Deeds

