

SURVEY &
REMONUMENTATION

SEP 08 1998

SECTION

LAND CORNER RECORDATION CERTIFICATE
Filing Requirement of Act 74, Mich. P.A. 1970

For corners in

Gogebic

(County)

Located In:

Corner Code #

- | | | |
|------------------------------------|---------------------------|------------|
| 1. Public Land Survey | T <u>49N</u> R <u>46W</u> | <u>G-5</u> |
| | T ___ R ___ | _____ |
| | T ___ R ___ | _____ |
| | T ___ R ___ | _____ |
| 2. Property Controlling in Section | S ___ T ___ R ___ | _____ |
| | S ___ T ___ R ___ | _____ |
| 3. Miscellaneous Property in Sec. | S ___ T ___ R ___ | _____ |
| | S ___ T ___ R ___ | _____ |

Register's Office }
Gogebic County } ss.

Received for record the
14th day of MAY
A. D. 1998 at 3:30 o'clock
P m., and recorded in
Liber 6 of CORNERS
on page 398
Ramona Collins Dep.
Register of Deeds

Register of Deeds Stamp & File Number

4. Lot No. _____, Recorded Plat _____
5. Private Claims _____

S.C. comm. to Sec's. 9, 10, 15 & 16, T49N, R46W

I, John P. Goss, in a field survey on April 16 1998 do hereby state that under requirements of P.A. 74, Michigan P.A. of 1970, the corner points mentioned in lines 1 and 2 above were in conformance with regulations and rules therefore as required in the current manual of survey instructions of the United States Department of the Interior, Bureau of Land Management or by a decree of a Court of Law and /or that the corner points mentioned in lines 3, 4 and 5 above were in conformance with the rules of the Michigan Board of Land Surveyors or by a Decree of a Court of Law; established, re-established, monumented, recovered, found as expressed below:

NOTE: Not more than 2 corners, all in the same town and range, may be recorded on this certificate.

A	B	C	D	E	F	G	H	I	J	K	L	M
1												
2	6	5	4	3	2	1						
3												
4	7	8	9	10	11	12						
5												
6	18	17	16	15	14	13						
7												
8	19	20	21	22	23	24						
9												
10	30	29	28	27	26	25						
11												
12	31	32	33	34	35	36						
13												

A. Description of original monument and accessories and/or subsequent restoration:

Corner established by William Burt, in 1848.

Original bearing trees: Yellow Birch 14" N 21° E 26 links
Hemlock 24" S 42° W 16 links

Donald D. Lappala, RIS, USFS, on April 22, 1966, found corner position marked by a 4" dia. concrete filled iron pipe with a 3 3/4 inch brass cap, stamped Gogebic Co. Park Commission, at record bearing and distance from the yellow birch tree and natural features. He recorded said corner in Liber 1, page 300 of Land Corners for Gogebic County. He established the following reference objects: 13" Sugar Maple - N 73° E - 14.0'; 12" Sugar Maple - S 34° E - 33.2'

B. Description of corner evidence found and/or method applied in restoring or reestablishing corner:

11" Sugar Maple - S 53° W - 17.0'

Found Donald D. Lappala, record monument and witnesses.

I updated the corner monument and accessories as noted below to state and county specification.


Act 74 research on file.

PEER GROUP APPROVED
Richard L. Dreda 5/13/98
COUNTY SURVEYOR

C. Description of monument for corner and accessories established to perpetuate locating the position of the corner:

From the 4" dia. concrete filled iron pipe, with 3 3/4" brass cap which reads: Gogebic County Park Commission. I established the existing and new reference objects:

- | | | |
|--------------------|---------|----------------|
| 19" Maple | N 73° E | 14.01' |
| 19" Maple | S 53° W | 16.96' |
| 18" Maple | S 34° E | 33.21' |
| 4" by 4" wood post | South | 2.9' (to face) |
| 6" Rail & sign | N 81° W | 1.8' (to face) |

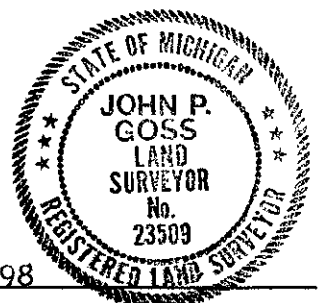

Signed by John P. Goss
Surveyor's Michigan License No. 23509

Date April 17, 1998

Fed. No. J-13