

SURVEY &
REMONUMENTATION

MAY 15 1997

COMMISSION

LAND CORNER RECORDATION CERTIFICATE

Filing Requirement of Act 74, Mich. P.A. 1970

For corners in Gogebic (County) Located In: _____ Corner Code # _____

1. Public Land Survey	T <u>49N</u> R <u>46W</u>	<u>I-4</u>
	T _____ R _____	_____
	T _____ R _____	_____
	T _____ R _____	_____
2. Property Controlling in Section	S _____ T _____ R _____	_____
	S _____ T _____ R _____	_____
3. Miscellaneous Property in Section	S _____ T _____ R _____	_____
	S _____ T _____ R _____	_____
4. Lot No. _____, Recorded Plat _____		
5. Private Claims _____		

Register's Office }
Gogebic County } 86.

Received for record the 25TH day of NOVEMBER A. D. 1996 at 10:50 o'clock A m., and recorded in Liber 6 of COGNES page 86
Ramona Collins Deputy
Register of Deeds

Register of Deeds Stamp & File Number

One-quarter corner common to Sections 10 & 11, T49N, R46W.

I, John R. Garske, in a field survey on November 6, 1996 do hereby certify that under requirements of P.A. 74, Michigan P.A. of 1970, the corner points mentioned in lines 1 and 2 above were in conformance with regulations and rules therefore as required in the current manual of survey instructions of the United States Department of the Interior, Bureau of Land Management or by a decree of a Court of Law and/or that the corner points mentioned in lines 3, 4 and 5 above were in conformance with the rules of the Michigan Board of Professional Surveyors or by a Decree of a Court of Law; established, re-established, monumented, re-monumented, recovered, found as expressed below:

NOTE: Not more than 4 corners, all in the same town and range, may be recorded on this certificate.

A	B	C	D	E	F	G	H	I	J	K	L	M
2	6	5	4	3	2	1						
3												
4	7	8	9	10	11	12						
5												
6	18	17	16	15	14	13						
7												
8	19	20	21	22	23	24						
9												
10	30	29	28	27	26	25						
11												
12	31	32	33	34	35	36						
13												

A. Description of original monument and accessories and/or subsequent restoration:

- In 1848 William Burt, U.S.D.S., set a cedar post from which a 6" cedar bears N58°E - 21 links and a 14" cedar S35° - 15 links.
- 1935 - U.S.D.A., O.C. Schoenfeld found a 4'x4'x36" wood post at the corner location, set a tag in a 14" cedar near the corner.
- 1966 - Don Lappala, R.L.S., U.S.F.S., Suveyor found a tag on 16" cedar windfall at the corner position and left a corner monument at the location but did not monument.

B. Description of corner evidence found and/or method applied in restoring or reestablishing corner:

I found a 2" diameter x 5' long concrete filled iron pipe lying on the ground with the remains of two bearing trees:
1- Found a "hacked up" 12" cedar - 10' stub; 2- 12" cedar (up-rooted) with rusty tag. This position checked with the G.L.O. call of an east bank of a ravine being 330' south of the corner and the 293.7' call north to a stream. The rusty tag we found was from a 1935 corner search as noted above. I monumented this position after reviewing Lappala's 1966 notes and checking the natural feature ties and distances north (2514.35') and south (2645.94') to monumented corner positions.


(Record research on file)

PEER GROUP APPROVED
Richard P. Deakin 11/11/96
COUNTY REPRESENTATIVE

C. Description of monument for corner and accessories established to perpetuate locating the position of the corner:

Set a 2" diameter x 5' long iron pipe filled with concrete. A 3 1/4" diameter brass cap is stamped: E 1/4, S-10, S-11, T49N, R46W, 1966, R.L.S. 12585, 1996, R.L.S. 28410. Established the following bearing trees and reference object:

- 6" steel rail with sign - S85°E - 1.96 feet
- 6" Y. birch - S25°E - 28.04 feet
- 8" sugar - S72°W - 12.60 feet
- 6" twin sugar - N24°W - 21.40 feet

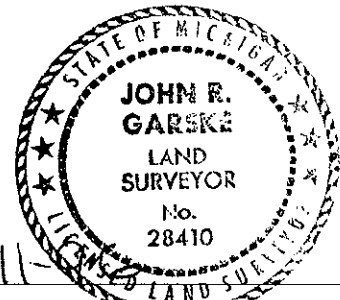

Signed by John R. Garske
Surveyor's Michigan License No. 28410

Date 11-11-96

FORM APPROVED BY MICHIGAN STATE BOARD OF PROFESSIONAL SURVEYORS, JAN. 28, 1971
REVISED MAY 14, 1975
REVISED JAN., 1933