


JAN 20 1999

LAND CORNER MONUMENTS

SECTION

T. 49 N., R. 46 W.

IRONWOOD TOWNSHIP

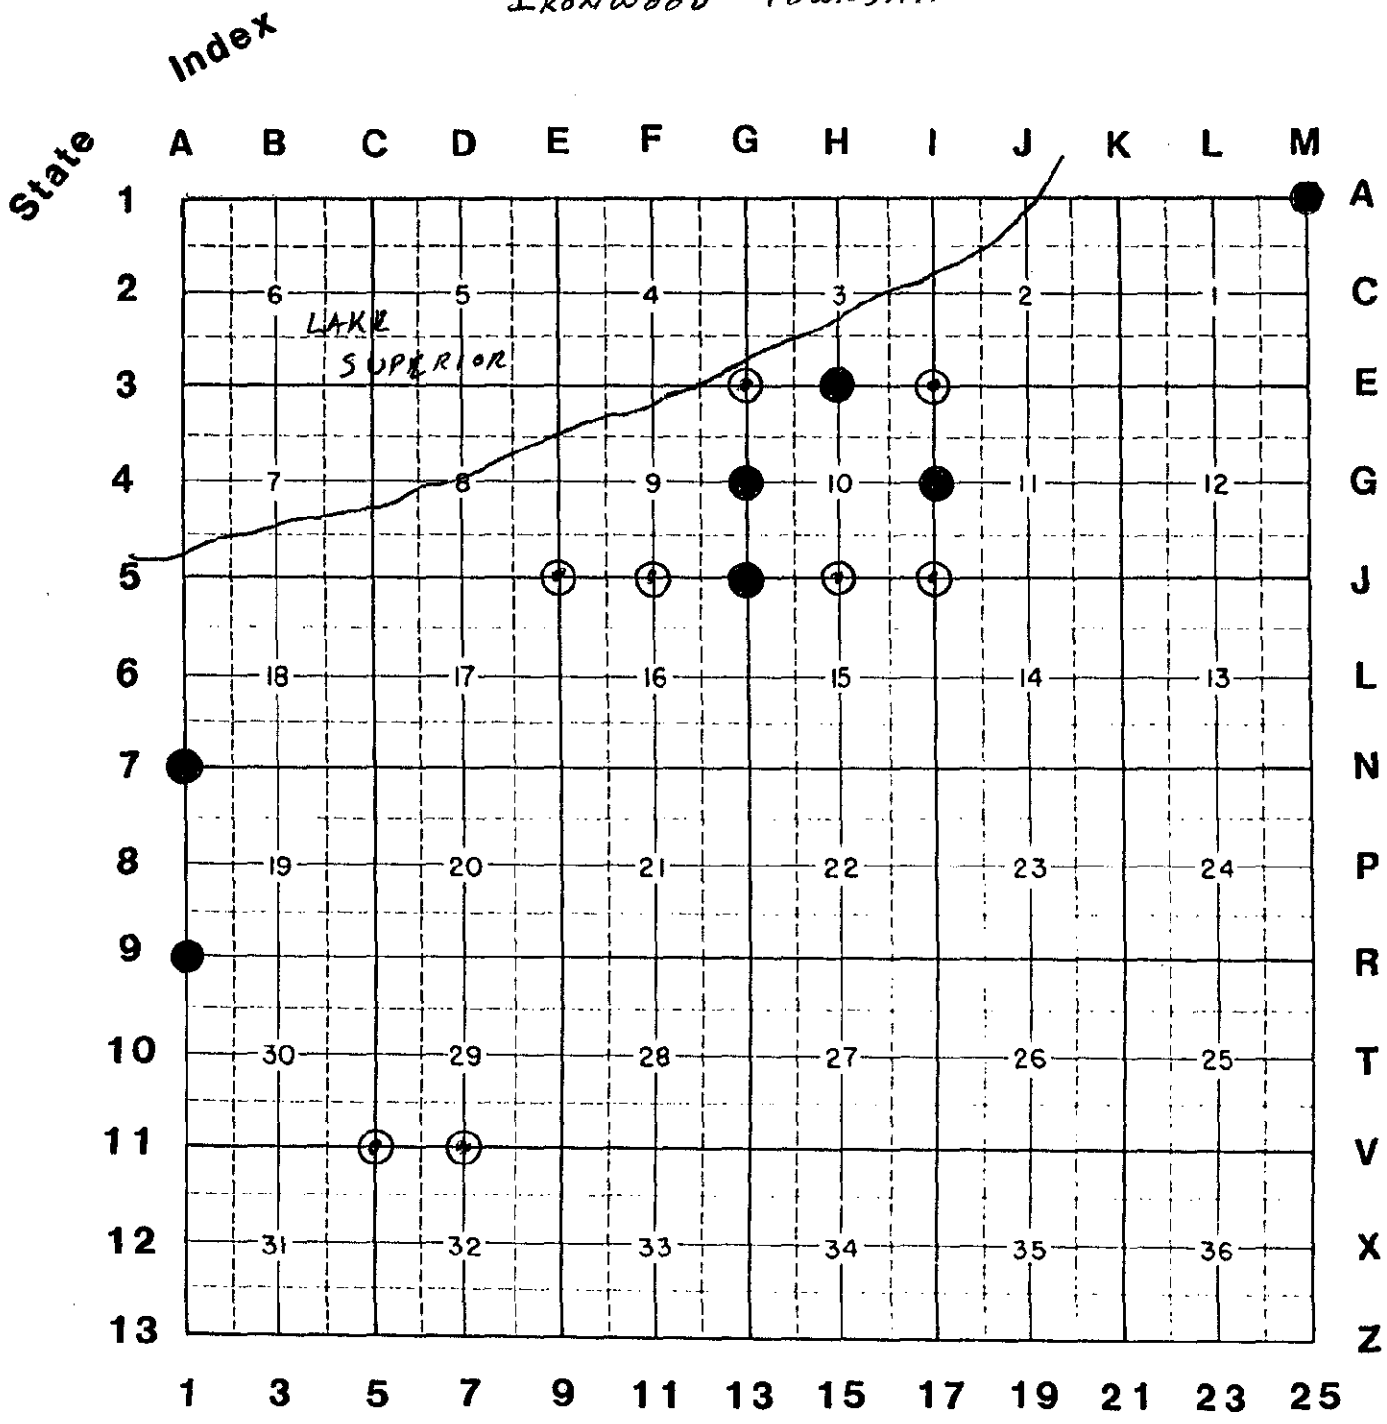

AS OF 12/31/98

LEGEND

Federal Index

- GLO Corners researched
- ⊙ GLO Corners monumented, not approved
- ⊗ GLO Corners approved
- GLO Corners approved & reported to State

T. 49 N., R. 46 W.