SURVEY &
REMONUMENTATION

1993

COMMISSION

LAND CORNER RECORDATION CERTIFICATE
Filing Requirement of Act 74, Mich. P.A. 1970

Register's Office } ss.
Gogebic County }

Received for record the 16TH day of DECEMBER A. D. 1993 at 2:25 o'clock P m., and recorded in Liber 4 of CORNERS on page 306.

Betty Lorie Deputy
Register of Deeds

Register of Deeds Stamp & File Number

For corners in Gogebic (County) Located In: Corner Code #

1. Public Land Survey Section 15 T 49N R 47W H-7
   T ___ R ___
   T ___ R ___
   T ___ R ___
2. Property Controlling S ___ T ___ R ___
   in Section S ___ T ___ R ___
3. Miscellaneous S ___ T ___ R ___
   Property in Sec. S ___ T ___ R ___

4. Lot No. ___, Recorded Plat ___
5. Private Claims ___

One-quarter corner S-15 & 22.

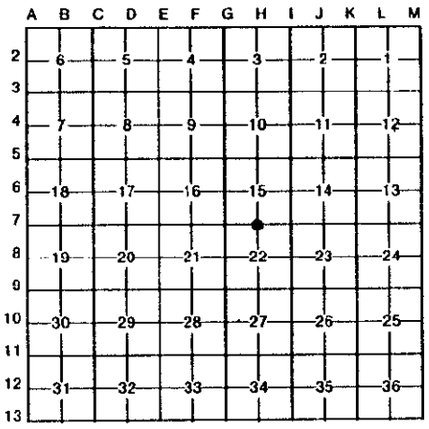

I, John R. Garske, in a field survey on December 7, 19 93, do hereby certify that under requirements of P.A. 74, Michigan P.A. of 1970, the corner points mentioned in lines 1 and 2 above were in conformance with regulations and rules therefore as required in the current manual of survey instructions of the United States Department of the Interior, Bureau of Land Management or by a decree of a Court of Law and/or that the corner points mentioned in lines 3, 4 and 5 above were in conformance with the rules of the Michigan Board of Land Surveyors or by a Decree of a Court of Law; established, re-established, monumented, re-monumented, recovered, found as expressed below:

NOTE: Not more than 4 corners, all in the same town and range, may be recorded on this certificate.

A. Description of original monument and accessories and/or subsequent restoration:

Original survey by William Ives, Deputy Surveyor, on September 28, 1848. Set quarter post at 40chs (east to west) bearing trees:

14" aspen - S62°E - 18 links
7" hemlock - N40°W - 19 links

No original evidence found.

B. Description of corner evidence found and/or method applied in restoring or reestablishing corner:

I set the corner by single proportional measurement on line and one-half the distance between opposing section corners in accordance with the original government survey.

C. Description of monument for corner and accessories established to perpetuate locating the position of the corner:

Set a standard Bernsten 2 1/2" aluminum pipe with 3 1/2" aluminum cap stamped: County Remonumentation; T49N, R47W; 1/4 cor.; S-15; S-22; 1993; RLS 28410. Established the following bearing trees and reference objects:

12" hemlock - S65°E - 31.25 feet
14" hemlock - N24°W - 29.62 feet
11" cedar - S75°W - 24.85 feet
Steel sign post - south - 1.22 feet

STATE OF MICHIGAN
JOHN R. GARSKE
LAND SURVEYOR
No. 28410
LICENSED LAND SURVEYOR

Signed by John R Garske Date 12/9/93

Surveyor's Michigan License No. 28410

FORM APPROVED BY MICHIGAN STATE BOARD OF LAND SURVEYORS, JAN. 28, 1971
REVISED MAY 14, 1975
REVISED JAN., 1983

FED: N-15 306