

MAY 16 1997

COMMISSION

LAND CORNER RECORDATION CERTIFICATE Register's Office }
Filing Requirement of Act 74, Mich. P.A. 1970 Gogebic County } 38.

For corners in

Gogebic
(County)

Located In: Corner Code #

- 1. Public Land Survey T49NR 47W I-13
T48NR 47W I-1
T ___ R ___
T ___ R ___
- 2. Property Controlling in Section S ___ T ___ R ___
S ___ T ___ R ___
- 3. Miscellaneous Property in Sec. S ___ T ___ R ___
S ___ T ___ R ___

Received for record the
16th day of AUGUST
A. D. 1996 at 2:30 o'clock
P. M., and recorded in
Liber 6 of CORNERS
on page 38
Richard J. Brown
Register of Deeds

Register of Deeds Stamp & File Number

- 4. Lot No. _____, Recorded Plat _____
- 5. Private Claims _____
Sec. Cor. comm. to 2,3,34 & 35

A	B	C	D	E	F	G	H	I	J	K	L	M
1								●				
2	6		5		4		3		2		1	
3												
4	7		8		9		10		11		12	
5												
6	18		17		16		15		14		13	
7												
8	19		20		21		22		23		24	
9												
10	30		29		28		27		26		25	
11												
12	31		32		33		34		35		36	
13								●				

I, John P. Goss, in a field survey on Aug. 21, 1996 do hereby state that under requirements of P.A. 74, Michigan P.A. of 1970, the corner points mentioned in lines 1 and 2 above were in conformance with regulations and rules therefore as required in the current manual of survey instructions of the United States Department of the Interior, Bureau of Land Management or by a decree of a Court of Law and /or that the corner points mentioned in lines 3, 4 and 5 above were in conformance with the rules of the Michigan Board of Land Surveyors or by a Decree of a Court of Law; established, re-established, monumented, recovered, found as expressed below:

NOTE: Not more than 2 corners, all in the same town and range, may be recorded on this certificate.


A. Description of original monument and accessories and/or subsequent restoration:
Original corner established by William Burt in Sept., 1847. Set Cedar Post
Original bearing trees: Tamarack 16" N 43° W 69 links
W. Pine 14" N 87° W 55 links
Neal Spherhake found the original bearing tree N 87° W and used notch on tree to reset corner in 1983. He set a 3' long iron pipe with cap stamped to note corner location. He established the following new bearing trees: Black Ash 6" S 48° W- 31 links (20.46'); Black Ash N 08° W- 29 links (19.14'). He recorded said corner in Liber 2 of Land Corners for Gogebic County on page 491.

B. Description of corner evidence found and/or method applied in restoring or reestablishing corner:
I found the 1" iron pipe set by Neal Spherhake and it checked with his witnesses which are now down trees; I updated the corner monument and accessories as noted below to state and county specification.
Act 74 research on file.

C. Description of monument for corner and accessories established to perpetuate locating the position of the corner:
From the 1" iron pipe with cap stamped T. 49-48 N, R.47 W. S-34, S-35, S-2, S-3. I established the following bearing trees and reference objects.

- 14" Cedar N 47° W 38.95'
- 5" Black Ash Due N 49.40'
- 6' rail & sign S 26° E 1.25'
- 5" Cedar post N 30° E 0.65'

NEER GROUP RECEIVED
Richard P. D. Zahn 9/12/96
COUNTY REGISTER

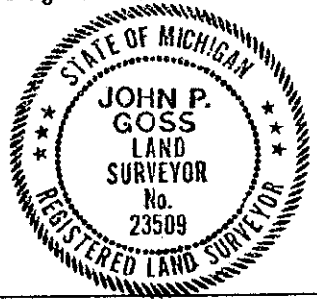

Signed by John P. Goss
Surveyor's Michigan License No. 23509

Date Aug. 22, 1996

Fed. No. A-17 or Z-17