SURVEY &
REMONUMENTATION

OCT 0 8 1996

COMMISSION

Register's Office }
Gogebic County } ss.

Received for record the 16TH day of AUGUST A. D. 1996 at 11:15 o'clock A m., and recorded in Liber 5 of CORNERS on page 31

Ramona Collins, Deputy
Register of Deeds

Register of Deeds Stamp & File Number

LAND CORNER RECORDATION CERTIFICATE

Filing Requirement of Act 74, Mich. P.A. 1970

For corners in Gogebic (County)

	Located In:	Corner Code #
1. Public Land Survey	T ~~49N~~ R ~~48W~~	~~C-13~~
	T 48N R 48W	C-1
	T ____ R ____	
	T ____ R ____	
2. Property Controlling	S ____ T ____ R ____	
in Section	S ____ T ____ R ____	
3. Miscellaneous	S ____ T ____ R ____	
Property in Section	S ____ T ____ R ____	

4. Lot No. _____, Recorded Plat _____
5. Private Claims _____

Section Corner 31,32, 5, &6, T49N-T48N, R48W.

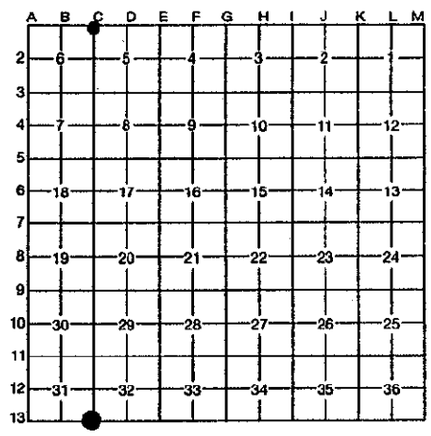

I, John R. Garske, in a field survey on May 16, 19 95, do hereby certify that under requirements of P.A. 74, Michigan P.A. of 1970, the corner points mentioned in lines 1 and 2 above were in conformance with regulations and rules therefore as required in the current manual of survey instructions of the United States Department of the Interior, Bureau of Land Management or by a decree of a Court of Law and/or that the corner points mentioned in lines 3, 4 and 5 above were in conformance with the rules of the Michigan Board of Professional Surveyors or by a Decree of a Court of Law; established, re-established, monumented, re-monumented, recovered, found as expressed below:

NOTE: Not more than 4 corners, all in the same town and range, may be recorded on this certificate.

A. Description of original monument and accessories and/or subsequent restoration:

- In 1847 William Burt set a cedar post with the following bearing trees:
  Hemlock 22"-N13°E-8 links
  White Birch 10"-N29°W-45 links.
- Township Subdivision by William Ives, August 9, 1848
  White Birch 8"-S24°E-35 links
  Cedar 8"-S64°E-12 links
- In October 1988 J. Garske RLS 28410 reestablished the corner position as recorded 11-16-88 in Liber 3 pg. 273, the corner consisting of 2 1/2 O.D. iron pipe with stamped brass cap noting corner, date and RLS number. The following bearing trees were established:
  14" Maple-N80°W-4.00 feet 8" Balsam S48°E-8.85 feet
  8" Maple-S46°W-16.28 feet

B. Description of corner evidence found and/or method applied in restoring or reestablishing corner:

I found the 1988 monument set above which checks with the accessories established in 1988.

P.A. 74 Research on file.

C. Description of monument for corner and accessories established to perpetuate locating the position of the corner:

Accepted 2 1/2" O.D. iron pipe with stamped brass cap and used existing bearing trees:
16" Maple - N80°W - 4.00 feet (existing)
10" Maple - S46°W - 16.28 feet (existing)
10" Balsam - S48°E - 8.85 feet (existing)
Steel sign rail - N57°E - 0.60 feet (new)

PEER GROUP APPROVED
Richard P. Dishn 8/14/96
COUNTY REPRESENTATIVE

STATE OF MICHIGAN
JOHN R. GARSKE
LAND SURVEYOR
No. 28410
LICENSED LAND SURVEYOR

Signed by John R Garske Date 8-4-96

Surveyor's Michigan License No. 28410

FORM APPROVED BY MICHIGAN STATE BOARD OF PROFESSIONAL SURVEYORS, JAN. 28, 1971
REVISED MAY 14, 1975
REVISED JAN., 1983