

SURVEY & REMONUMENTATION

AUG 08 1997

COMMISSION

LAND CORNER RECORDATION CERTIFICATE
Filing Requirement of Act 74, Mich. P.A. 1970

Register's Office }
Gogebic County }

Received for record the
11th day of JUNE
A. D. 1997 at 10:35 o'clock
A m., and recorded in
Liber 6 of CORNERS
on page 138
Colleen M. Kitchin, Deputy
Register of Deeds

For corners in

GOGEBIC
(County)

Located In:	Corner Code #
<u>T49N R 48W</u>	<u>F-13</u>
<u>T48N R 48W</u>	<u>F-1</u>
T R	
T R	
S T R	
S T R	
S T R	
S T R	

1. Public Land Survey

2. Property Controlling in Section

3. Miscellaneous Property in Sec.

4. Lot No. _____, Recorded Plat _____
5. Private Claims _____

Quarter Corner common to Sections 33 & 4, T49N & T48N, R48W.

I, Earl W. Applekamp, in a field survey on May 21, 1997 do hereby state that under requirements of P.A. 74, Michigan P.A. of 1970, the corner points mentioned in lines 1 and 2 above were in conformance with regulations and rules therefore as required in the current manual of survey instructions of the United States Department of the Interior, Bureau of Land Management or by a decree of a Court of Law and /or that the corner points mentioned in lines 3, 4 and 5 above were in conformance with the rules of the Michigan Board of Land Surveyors or by a Decree of a Court of Law; established, re-established, monumented, recovered, found as expressed below:

NOTE: Not more than 2 corners, all in the same town and range, may be recorded on this certificate.

Register of Deeds Stamp & File Number

A	B	C	D	E	F	G	H	I	J	K	L	M
1												
2	6		5		4		3		2		1	
3												
4	7		8		9		10		11		12	
5												
6	18		17		16		15		14		13	
7												
8	19		20		21		22		23		24	
9												
10	30		29		28		27		26		25	
11												
12	31		32		33		34		35		36	
13												

A. Description of original monument and accessories and/or subsequent restoration:

Original corner established by William A. Burt, U.S. Deputy Surveyor, September 13, 1847. Set Wood Post.

ORIGINAL BEARING TREES:

12" HEMLOCK	N27°E	25.08 feet
12" Cedar	N63°W	24.42 feet

B. Description of corner evidence found and/or method applied in restoring or reestablishing corner:


No original evidence was found due to construction of Lake Road. No current evidence of the corner was found. Corner was re-established by single proportionate measure and on line with opposite Section corners to the East & West.

Research on file with the Gogebic Remonumentation Representative.

PEER GROUP APPROVED
Richard L. Deahn 6/10/97
COUNTY REPRESENTATIVE

C. Description of monument for corner and accessories established to perpetuate locating the position of the corner:

At the corner position I set a 2 1/2"X30" aluminum pipe with a 3" stamped cap 19.9 feet South of the centerline of Lake Road and flush with the ground 5 feet North of the ditch. I established a reference monument, a 2 1/2"X30" aluminum pipe with a 3" cap stamped to read: County Remonumentation, T49N, T48N, R48W, 1/4, S33, S4, 1997, P.S. 17610. I established three bearing trees.

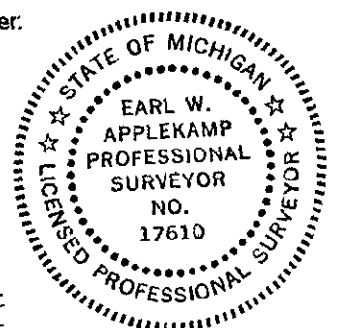

7" Maple	N43°W	73.31 feet	-	7" Basswood	S46°E	58.17 feet
4" Maple	N19°E	73.89 feet	-	REF. MON.	S19°W	36.33 feet

Signed by Earl W. Applekamp
Surveyor's Michigan License No. 17610

Date May 29, 1997