SURVEY &
REMONUMENTATION

OCT 0 3 1996

COMMISSION

LAND CORNER RECORDATION CERTIFICATE

Filing Requirement of Act 74, Mich. P.A. 1970

Register's Office
Gogebic County } ss.

Received for record the 16TH day of AUGUST A. D. 1996 at 10:30 o'clock A m., and recorded in Liber 5 of CORNERS on page 405.

Ramona Collins Deputy
Register of Deeds

Register of Deeds Stamp & File Number

For corners in

Gogebic (County)

	Located In:	Corner Code #
1. Public Land Survey	T 48N R 48W	G-1
	T 49N R 48W	G-13
	T R	
	T R	
2. Property Controlling	S T R	
in Section	S T R	
3. Miscellaneous	S T R	
Property in Sec.	S T R	

4. Lot No. _____ , Recorded Plat _____
5. Private Claims _____

Sec. cor. comm. to sec's 3,4,33 & 34

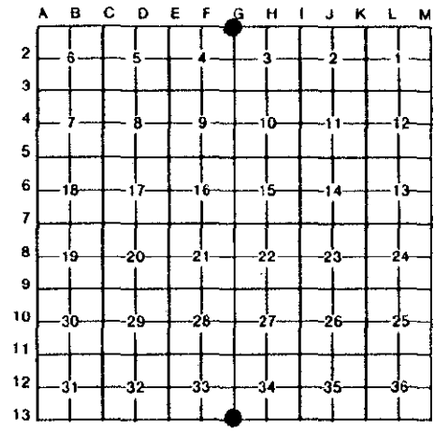

I, John P. Goss, in a field survey on June 15, 1996, do hereby certify that under requirements of P.A. 74, Michigan P.A. of 1970, the corner points mentioned in lines 1 and 2 above were in conformance with regulations and rules therefore as required in the current manual of survey instructions of the United States Department of the Interior, Bureau of Land Management or by a decree of a Court of Law and/or that the corner points mentioned in lines 3, 4 and 5 above were in conformance with the rules of the Michigan Board of Land Surveyors or by a Decree of a Court of Law; established, re-established, monumented, re-monumented, recovered, found as expressed below:

NOTE: Not more than 4 corners, all in the same town and range, may be recorded on this certificate.

A. Description of original monument and accessories and/or subsequent restoration:

Original corner established by Wm. A. Burt in 1847. Set Cedar Post
Original bearing trees: Fir 12" N 33° W 9 links
Lynn 9" N 59° W 28 links

No original evidence found due to road construction.

B. Description of corner evidence found and/or method applied in restoring or reestablishing corner:

Found 5/8 inch rebar in ceterline of Lake Road and road to the North. This corner position shown on Gogebic County Road Commission Plan of 1928 for Lake Road. The corner has been used in various surveys and is generally accepted as the Section corner by area residents. I accepted this corner position as the most probable location of the true section corner. I updated the corner monument and accessories as noted below to state and county specification. Act 74 research on file.

PEER GROUP APPROVAL
Richard L. Drahn 8/8/96
COUNTY REPRESENTATIVE

C. Description of monument for corner and accessories established to perpetuate locating the position of the corner:

At 2" below asphalt surface I set a 2½" brass cap with a 2" stem over the 5/8" rebar. Cap is stamped T.48-49 N., R.48 W.; S-3, S-4, S-33, S-34; 1996, P.S. 23509. I established the following bearing trees and references obects.

D.H. Nail in 7" Maple N 31° E 42.30'
D.H. Nail in 5" Basswood N 31° W 41.67'
D.H. Nail in P.Pole S 58° W 76.77'
Reference Monument consisting of a 2½" by 30" Aluminum monument with a 3¼" aluminum cap, stamped to indicated corner position.
S 01° E- 43.55', with 6' rail and sign 0.92'.

STATE OF MICHIGAN
JOHN P. GOSS
LAND SURVEYOR
No. 23509
REGISTERED LAND SURVEYOR

Signed by John P Goss Date June 21, 1996

Surveyor's Michigan License No. 23509

Fed. No. A-13

FORM APPROVED BY MICHIGAN STATE BOARD OF LAND SURVEYORS, JAN. 28, 1971
REVISED MAY 14, 1975
REVISED JAN. 1983