

COMMISSION
REMONUMENTATION

MAY 16 1997

COMMISSION

LAND CORNER RECORDATION CERTIFICATE
Filing Requirement of Act 74, Mich. P.A. 1970

Register's Office
Gogebic County

For corners in

Gogebic

(County)

Located in:

Corner Code #

1. Public Land Survey

T 50N	R 45W	A	12
T 50N	R 46W	M	-12
T	R		
T	R		
S	T	R	
S	T	R	
S	T	R	
S	T	R	

2. Property Controlling in Section

3. Miscellaneous Property in Sec.

4. Lot No. _____, Recorded Plat _____
5. Private Claims _____

1/4 cor. common to sec's 31 & 36

I, John P. Goss, in a field survey on Nov. 1, 1996 do hereby state that under requirements of P.A. 74, Michigan P.A. of 1970, the corner points mentioned in lines 1 and 2 above were in conformance with regulations and rules therefore as required in the current manual of survey instructions of the United States Department of the Interior, Bureau of Land Management or by a decree of a Court of Law and /or that the corner points mentioned in lines 3, 4 and 5 above were in conformance with the rules of the Michigan Board of Land Surveyors or by a Decree of a Court of Law; established, re-established, monumented, recovered, found as expressed below:

NOTE: Not more than 2 corners, all in the same town and range, may be recorded on this certificate.

Received for record the
12th day of DECEMBER
A. D. 1996 at 2:30 o'clock
P m., and recorded in
Liber 6 of CORNERS
on page 43
Ramona Collins Deputy
Register of Deeds

Register of Deeds Stamp & File Number

	A	B	C	D	E	F	G	H	I	J	K	L	M
1													
2	6		5		4		3		2		1		
3													
4	7		8		9		10		11		12		
5													
6	18		17		16		15		14		13		
7													
8	19		20		21		22		23		24		
9													
10	30		29		28		27		26		25		
11													
12	31		32		33		34		35		36		
13													

A. Description of original monument and accessories and/or subsequent restoration:

Original corner established by Austin Burt on Sept. 14, 1847. Set Cedar post.
Original bearing trees: Ash 12" S 45° W 26 links
Cedar 10" N 29° E 43 links.

Keith Sackett, RLS of DNR found a 1" iron pipe on August 5, 1980. Set from possible bearing tree by W.S. Bromley. Pipe fits good with land calls. He accepted said iron pipe and recorded it in Liber 2 page 120 of Land Corners for Gogebic County. He established the following bearing trees to the 1" iron pipe. 4" Maple- S 25° W- 21.5'- 1/4 S, NBT; 4" Maple- N 33° E- 33.3'- 1/4 S, NBT; 5" Ash- N 33° W- 40.8'- 1/4 S, NBT.

B. Description of corner evidence found and/or method applied in restoring or reestablishing corner:

I founded the 1" iron pipe and it checked with Keith Sackett witness. I updated the corner monument and accessories as noted below to state and county specification.

Act 74 research on file.

PEER GROUP APPROVED
Richard P. Widom 12/11/96
COUNTY REPRESENTATIVE

C. Description of monument for corner and accessories established to perpetuate locating the position of the corner:


I replaced the 1" by 4' iron pipe with a 2 1/2" by 30" aluminum pipe with a 3 1/4" aluminum cap stamped: County Remonumentation; 1/4; S-31, S-36; T 50N, R.45-46 W., 1996, P.S. 23509. I established the following existing and new bearing trees and reference objects.

6" Maple	S 25° W	21.52'	S 1/4, NBT
8" Maple	N 33° E	33.57'	S 1/4, NBT
9" Ash	N 33° W	41.00'	S 1/4, NBT
3" Y. Birch	S 62° E	31.12'	
6' Rail & sign	South	1.53'	

Measurement to trees are to nail in side of tree.

Signed by John P. Goss
Surveyor's Michigan License No. 23509

Date Nov 2, 1996

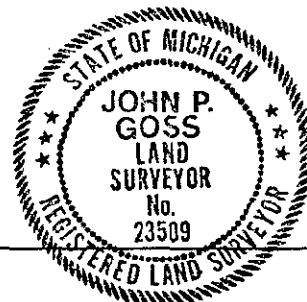

Fed. No. X-1