

SURVEY & REMONUMENTATION

MAY 16 1997

LAND CORNER RECORDATION CERTIFICATE Register's Office }
 Gogebic County } ca.
 Filing Requirement of Act 74, Mich. P.A. 1970

For corners in


Gogebic (County) Located In: Corner Code #

1. Public Land Survey	T49NR 45W	A- 1
	<u>T50NR 45W</u>	<u>A- 13</u>
	T49NR 46W	M- 1
	T50NR 46W	M- 13
2. Property Controlling in Section	S ___ T ___ R ___	___
3. Miscellaneous Property in Sec.	S ___ T ___ R ___	___

Received for record the
12th day of DECEMBER
 A. D. 1996 at 2:30 o'clock
P m., and recorded in
 Liber 6 of CORNERS
 on page 90
Ramona L. Collins, Deputy
 Register of Deeds

Register of Deeds Stamp & File Number

4. Lot No. _____, Recorded Plat _____
 5. Private Claims _____
 Sec. cor. common to sec's. 31, 36, 6 & 1

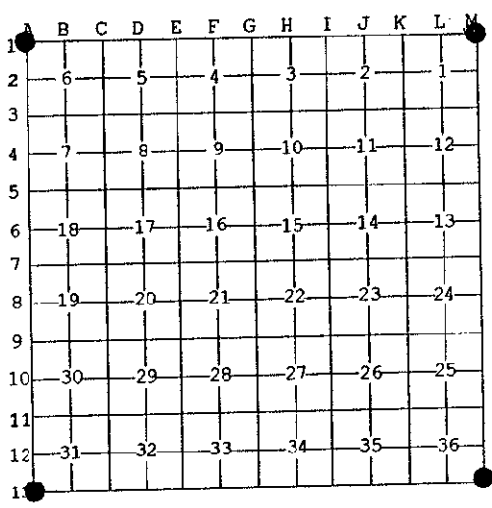

I, John P. Goss, in a field survey on Oct. 16, 1996 do hereby state that under requirements of P.A. 74, Michigan P.A. of 1970, the corner points mentioned in lines 1 and 2 above were in conformance with regulations and rules therefore as required in the current manual of survey instructions of the United States Department of the Interior, Bureau of Land Management or by a decree of a Court of Law and /or that the corner points mentioned in lines 3, 4 and 5 above were in conformance with the rules of the Michigan Board of Land Surveyors or by a Decree of a Court of Law; established, re-established, monumented, recovered, found as expressed below:

NOTE: Not more than 2 corners, all in the same town and range, may be recorded on this certificate.

A. Description of original monument and accessories and/or subsequent restoration:
 Original corner established by Austin Burt in Sept. 1847. Set Cedar post.
 Original bearing trees: Hemlock 14" S 48° E 40 links
 B. Ash 12" N 51° W 52 links
 On July 31, 1980, Keith Sackett, RLS for DNR found a 2" I.D. iron pipe marked T.49-50 N., R.45-46 W.; TWN., 31, 36, 6 & 1, 1959. He accepted said corner and recorded it in Liber 2, page 124 of Land Corners for Gogebic County. He established the following bearing trees and reference objects: 8" Ash- S 66° W- 23.7; S-1, NBT; 2" W. Birch- S 78° E- 22.6', S-6, NBT; 5" Maple- N 29° W- 29.7, S-36, NBT.

B. Description of corner evidence found and/or method applied in restoring or reestablishing corner:
 I found the 2" I.D. iron pipe with cap marked T. 49-50 N., R.45-46 W., TWN; 31, 36, 6, & 1; 1959. It checked with Keith Sackett witnesses. I updated the accessories as noted below to state and county specification.


Act 74 research on file.

PEER GROUP APPROVED
Richard R. Deakin 12/11/96
 COUNTY REESTABLISHMENT

C. Description of monument for corner and accessories established to perpetuate locating the position of the corner:
 From the 2" I.D. iron pipe with cap marked T.49-50 N., R.45-46 W., TWN; 31, 36, 6, & 1; 1959. I established the existing and new bearing trees and reference objects.

10" Ash	S 66° W	24.34'	S-1, NBT
5" W. Birch	S 78° E	22.83'	S-6, NBT
9" Maple	N 29° W	30.00'	S-36, NBT
8" Maple	N 16° E	33.37'	
6' Rail & Sign	North	1.31'	

Measurments to trees are to nail in side of tree.

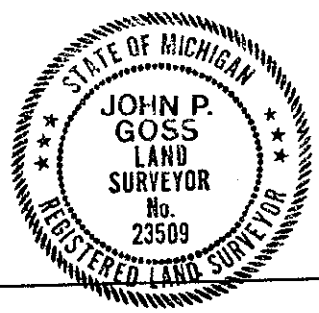

Signed by John P. Goss
 Surveyor's Michigan License No. 23509
 Fed. No. Z-1

Date Oct 17, 1996