

MAY 16 1997

COMMISSION

LAND CORNER RECORDATION CERTIFICATE Register's Office }
Filing Requirement of Act 74, Mich. P.A. 1970 Gogebic County } 3%

For corners in

Gogebic
(County)

Located in:

Corner Code #

- 1. Public Land Survey T50NR45W C-11
T R
T R
- 2. Property Controlling in Section S T R
S T R
- 3. Miscellaneous Property in Sec. S T R
S T R

Received for record the
16th day of August
 A. D. 1996 at 2:30 o'clock
P m. and recorded in
 Liber 6 of CORNERS
 on page 42
Richard J. Swanson
 Register of Deeds

Register of Deeds Stamp & File Number

4. Lot No. _____, Recorded Plat _____
 5. Private Claims _____
 Sec. cor. comm. to sec's. 29, 30, 31 & 32

I, John P. Goss, in a field survey on Sept. 2, 1996 do hereby state that under requirements of P.A. 74, Michigan P.A. of 1970, the corner points mentioned in lines 1 and 2 above were in conformance with regulations and rules therefore as required in the current manual of survey instructions of the United States Department of the Interior, Bureau of Land Management or by a decree of a Court of Law and/or that the corner points mentioned in lines 3, 4 and 5 above were in conformance with the rules of the Michigan Board of Land Surveyors or by a Decree of a Court of Law; established, re-established, monumented, recovered, found as expressed below:

NOTE: Not more than 2 corners, all in the same town and range, may be recorded on this certificate.

A	B	C	D	E	F	G	H	I	J	K	L	M
1												
2	6	5	4	3	2	1						
3												
4	7	8	9	10	11	12						
5												
6	18	17	16	15	14	13						
7												
8	19	20	21	22	23	24						
9												
10	30	29	28	27	26	25						
11												
12	31	32	33	34	35	36						
13												


A. Description of original monument and accessories and/or subsequent restoration:
 Original corner established by Austin Burt on July 26, 1848. Set Maple post.
 Original bearing trees: Sugar 12" S 35° W 47 links
 Sugar 12" N 75° E 72 links
 Keith Sackett, R.L.S. of D.N.R. on July 29, 1980 restored corner by possible bearing tree (Sugar 12" S 35° W 47 links) and land calls. He set a 1" iron pipe with 4" aluminum cap stamped to note corner location. He recorded said corner in Liber 2 on page 114 of Land Corners for Gogebic County, with the following bearing trees: 7" Sugar- N 7° E- 10.2', S-29, NBT; 5" Sugar- S 55° E, 8.7', S-32, NBT; 14" Sugar- S 40° W- 11.2', S-31, NBT.

B. Description of corner evidence found and/or method applied in restoring or reestablishing corner:
 Found the 1" iron pipe with 4" aluminum cap stamped to note corner location and it checked with K. Sackett witnesses on his certification. I updated the corner accessories as noted below to state and county specification.
 Act 74 research on file.

PEER GROUP APPROVED
Richard L. Decker 9/12/96
 COUNTY REPRESENTATIVE

C. Description of monument for corner and accessories established to perpetuate locating the position of the corner:
 From the 1" iron pipe with 4" aluminum cap stamped to note corner location. I established the following existing and new bearing trees and reference objects.

- 9" Sugar N 07° E 10.66', S-29, NBT
- 7" Sugar S 55° E 8.88', S-32, NBT
- 18" Sugar S 40° W 11.59', S-31, NBT
- 10" Sugar N 63° W 28.90'
- 6' Rail & sign Due S 1.28'

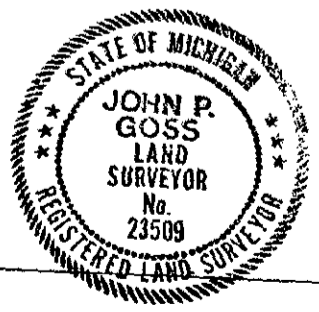

Signed by John P. Goss
 Surveyor's Michigan License No. 23509
 Fed. No. V-5

Date Sept. 2, 1996