

SURVEY & REMONUMENTATION

MAY 16 1997

COMMISSION

LAND CORNER RECORDATION CERTIFICATE
 Filing Requirement of Act 74, Mich. P.A. 1970

Register's Office }
 Gogebic County } ss.

For corners in

Gogebic
 (County)

Located In:

Corner Code #

- 1. Public Land Survey
 T50NR45W A-11
T50NR46W M-11
 T___R___
 T___R___
- 2. Property Controlling in Section
 S___T___R___
 S___T___R___
- 3. Miscellaneous Property in Sec.
 S___T___R___
 S___T___R___

Received for record the
16th day of August
 A. D. 1996 at 2:30 o'clock
P m., and recorded in
Liber 6 of CORNERS

on page 39
Richard J. Brown
 Register of Deeds

Register of Deeds Stamp & File Number

- 4. Lot No. _____, Recorded Plat _____
- 5. Private Claims _____

Sec. cor. comm. to sec's. 30, 31, 25 & 36

I, John P. Goss, in a field survey on Aug. 28, 1996 do hereby state that under requirements of P.A. 74, Michigan P.A. of 1970, the corner points mentioned in lines 1 and 2 above were in conformance with regulations and rules therefore as required in the current manual of survey instructions of the United States Department of the Interior, Bureau of Land Management or by a decree of a Court of Law and/or that the corner points mentioned in lines 3, 4 and 5 above were in conformance with the rules of the Michigan Board of Land Surveyors or by a Decree of a Court of Law; established, re-established, monumented, recovered, found as expressed below:

NOTE: Not more than 2 corners, all in the same town and range, may be recorded on this certificate.

	A	B	C	D	E	F	G	H	I	J	K	L	M
1													
2	6		5		4		3		2		1		
3													
4	7		8		9		10		11		12		
5													
6	18		17		16		15		14		13		
7													
8	19		20		21		22		23		24		
9													
10	30		29		28		27		26		25		
11													
12	31		32		33		34		35		36		
13													

A. Description of original monument and accessories and/or subsequent restoration:

Original corner established by Austin Burt on 18 July, 1848. Set post.
 Original bearing trees: Sugar 10" S 64° E 21 links
 Hemlock 10" N 79° W 45 links

Keith Sackett, R.L.S. of D.N.R. on July 29, 1980 found a 1" iron pipe reported to have been set by W.S. Bromley from possibly original bearing trees. Keith Sackett recorded the corner position in Liber 2 on page 118 of Land Corners for Gogebic County. From the 1" Iron pipe he established the following bearing trees: 6" W. Birch - S 65° W-19.0, S-36, NBT; 4" Sugar- N 37° W-20.6', S-25, NBT; 8" Aspen- N 20° E-14.7, S-30, NBT.

B. Description of corner evidence found and/or method applied in restoring or reestablishing corner:

I found the 1" iron pipe called for in Keith Sackett certification and it checked with his witnesses. I updated the corner monument and accessories as noted below to state and county specification.

Act 74 research on file.


C. Description of monument for corner and accessories established to perpetuate locating the position of the corner:

I replaced the 1" iron pipe with a 2½" by 30" aluminum pipe with a ¾" Aluminum cap stamped: County Remonumentation; T.50 N., R.45-46 W.; S-25, S-36, S-30, S-31; 1996; P.S. 23509. I established the following, and existing bearing trees and reference objects.

- 7" Sugar N 37° W 20.65'
- 12" Aspen N 20° E 14.75'
- 10" Aspen N 72° E 10.50'
- 6" W. Birch S 21° W 20.93'
- 6' Rail & sign S 05° E 1.14'

All distance are to nail in side of tree.

Richard L. Drab 9/22/96
 CC 23509

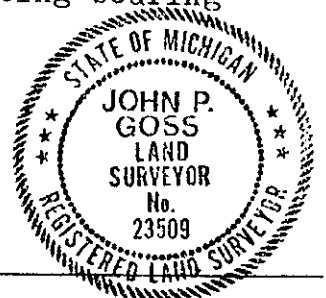

Signed by John P. Goss
 Surveyor's Michigan License No. 23509

Date Aug. 29, 1996

Fed. No. V-1 & V-25