

RFI


2000

**GRATIOT COUNTY REMONUMENTATION PROGRAM**  
**LAND CORNER RECORDATION CERTIFICATE**  
**Filing Requirement of Act 74, Mich. P.A. 1970**

SECTION

For corners in Gratiot Located In: Corner Code

#	(County)	Elba Township	
1. Public Land Survey	T 9N	R 1W	K-9
	T	R	
	T	R	
	T	R	
2. Property Controlling in Section	S	T	R
	S	T	R
3. Miscellaneous Property in Sec.	S	T	R
	S	T	R

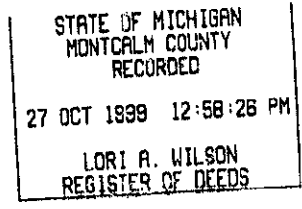

Register of Deeds Stamp & File Number

4. Lot No. \_\_\_\_\_, Recorded Plat \_\_\_\_\_  
 5. Private Claims \_\_\_\_\_

I, William G. Tingley, in a field survey on July 16, 1999, do hereby certify that under requirements of P.A. 74, Michigan P.A. of 1970, the corner points mentioned in lines 1 and 2 above were in conformance with regulations and rules therefore as required in the current manual of survey instructions of the United States Department of the Interior, Bureau of Land Management or by a decree of a Court of Law and/or that the corner points mentioned in lines 3, 4 and 5 above were in conformance with the rules of the Michigan Board of Land Surveyors or by a Decree of a Court of Law; established, re-established, monumented, re-monumented, recovered, found as expressed below:

**NOTE: Not more than 2 corners, all in the same town and range, may be recorded on this certificate.**

A. Description of original monument and accessories and/or subsequent restoration:  
 1868, R.Thomas, GLO notes T9N-R1W, Page 13.

- Set post cor. Sec. 23,24,25 + 26.
- Elm 8" S45°E 16 links
- Sugar 8" N66°W 33 links

1879, R.J.Fraker Deputy County Surveyor, Field Book page 77.

- Stone Cor.
- Oak S56¼°E 1.49½ links
- Stone S62°W 33½ links ocf.

1880, R.J.F., Field Book Page 75

- Stone Cor.
- Oak S56¼°E 1.49½ links
- Stone S62°W 33½ links o.c.

Oct. 11, 1978, Jerry L. Jones #19838, Survey #G-3218, Liber 417, Page 601.

- S.E. Cor. Sec. 23., fd. 1/2" pipe in Mon. Box
- road sign post SW 43.47'
- Centerline intersection 3.7' E, 1.0' S.

Nov. 1, 1978, Jerry L. Jones #19838, Land Corner Recordation Certificate, Liber 1, Page 442.

Same as above.

July 19, 1994, Mark L. VanRaemdonck, Land Corner Recordation Certificate, Liber 539, Page 186.

- Northeast corner Section 26, T9N-R1W 3/4" pipe
- 36" conc. culv. S65°W 35.17'
- 36" conc. culv. N60°W 36.95'
- 24" CMP S60°E 39.72'
- Tele. Box N50°E 48.00'

Feb. 10, 1997, Wendy A. Papineau #41919, Survey #5-5087-97-5, Liber 568, Page 902

- Fnd pipe in Mon. Box 3.5' W. cl Mason Rd and 1.0' S. cl Taft Rd, SE Cor., Sec. 23, T9N-R1W
- T/C tele riser N45°E 48.00'
- Road sign post S60°W 42.75'
- Fnd.pk nail cl Mason Rd. East 3.27'
- Fnd. Spike w/tag E. fc P/P N25°W 205.48'

B. Description of corner evidence found and/or method applied in restoring or reestablishing corner:

Excavated 2' diameter hole by 4.0' deep, Found 1"x0.7' pipe 0.2 feet below the the surface in a Mon. box.

- T/C Cable riser box N48°E 47.80'
- Center Stop sign S60°W 42.80'

C. Description of monument for corner and accessories established to perpetuate locating the position of the corner:

- Set Standard Remonumentation Monument.
- T/C Cable riser box N48°E 47.80'
- Center Stop sign S60°W 42.80'
- T/C 36" Black Plastic Culvert N40°W 47.00'
- T/C 24" Steel Culvert S55°E 41.20'

This corner is accepted as a careful and faithful perpetuation of the position of the original corner.

1	A	B	C	D	E	F	G	H	I	J	K	L	M
2	6	5	4	3	2	1							
3													
4	7	8	9	10	11	12							
5													
6	18	17	16	15	14	13							
7													
8	19	20	21	22	23	24							
9													
10	30	29	28	27	26	25							
11													
12	31	32	33	34	35	36							
13													

ACCEPTED BY THE GRATIOT COUNTY SURVEY PEER GROUP AS THE OFFICIAL CORNER UNDER MICHIGAN PUBLIC ACT 345 OF 1990 AT A MEETING HELD 7-21-99.

*William Tingley*  
 William Tingley, PS, Chairman



Signed by William Tingley Date 7-21, 1999

Surveyor's Michigan License No. 30104

