

GRATIOT COUNTY REMONUMENTATION PROGRAM

MAR 23 1999

LAND CORNER RECORDATION CERTIFICATE

GRATIOT CO. MICH. RECORDED

Filing Requirement of Act 74, Mich. P.A. 1970

'98 DEC 22 AM 10 53

SECTION

Corner Code #

Located In: Township

Public Land Survey

Property Controlling in Section

Miscellaneous Property in Sec.

Lot No. Recorded Plat

Private Claims

Janet M. Davis REGISTER OF DEEDS

Register of Deeds Stamp & File Number

A	B	C	D	E	F	G	H	I	J	K	L	M
1												
2	6	5	4	3	2	1						
3												
4	7	8	9	10	11	12						
5												
6	18	17	16	15	14	13						
7												
8	19	20	21	22	23	24						
9												
10	30	29	28	27	26	25						
11												
12	31	32	33	34	35	36						
13												

William G. Tingley In a field survey on 2/25 19 98, hereby certify that under requirements of P.A. 74, Michigan P.A. of 1970, the corner points mentioned...

NOTE: Not more than 2 corners, all in the same town and range, may be recorded on this certificate.

Description of original monument and accessories and/or subsequent restoration:

1831, Joel Wright, G.L.O. Notes Intersect N. boundary at end of 5 miles (no witnesses given)

1852, Austin Burt, G.L.O. Notes Intersect W. boundary at end of 5 miles Beech 12 N8 W13 Beech 8 S45 E25

Sept. 1872 D.W.A., Field Book Stone marked T.C. Stone S52 W. 71 1/4 Stone N45 W. 60 o.c.f.

Oct. 1876, D.W.A., Field Book Stone 8x10x24 mr T.C. Stone S52 W 71 1/4 Stone N45 W. 60 Post 12 N 40 E. 37 3/4 Post 10 S 34 3/4 E. 57 1/2

Oct. 1876, D.W.A., Record of Minutes of Survey, Liber B, Page 228 (Stone on Top) Stone cor. T.C. 8"x10"x24" Stone S 52° W 71 1/4 Stone N 45° W 60

D.W.A., Record of Minutes of Survey, Liber A, Page 272, Liber B, Page 119 Stone Cor 8"x10"x24" Stone S52° W. 71 Post 12 N 40° E 37 3/4 Post 10 S 34 3/4 E. 57

May 1892, D.W.A., Record of Minutes of Survey, Liber C, Page 203 Stone Cor. 8"x10"x24" T.C. Stone S. 52°W. 71 1/4 Stone N. 45°W. 60

1892, D.W.A., Record of Minutes of Survey, Liber B, Page 107 Stone cor T.C. Stone South 52°W 71 1/4 Stone N 45° W. 60

August 12, 1996, Mark L. VanRaemdonck, Recorded Survey, Liber 561, Page 1429 Pipe in Monument Box

ACCEPTED BY THE GRATIOT COUNTY SURVEY PEER GROUP AS THE OFFICIAL CORNER UNDER MICHIGAN PUBLIC ACT 345 OF 1990 AT A MEETING HELD 3/18/98

William Tingley, PS, Chairman

Description of corner evidence found and/or method applied in restoring or reestablishing corner: Found 1"x1" iron pipe in monbox over stone and bits of clay tile.


- Found Nail & Tag #19003 south side power pole N60°E 41.70 Feet
Found Nail & Tag #30104 north side power pole S70°E 120.59 Feet
Found Nail & Tag #24622 north side power poie S35°W 66.38 Feet

Description of monument for corner and accessories established to perpetuate locating the position of the corner: Set standard Remonumentation corner between stones and over bits of clay tile.

- Found Nail & Tag #19003 south side power pole N60°E 41.70 Feet
Found Nail & Tag #30104 north side power pole S70°E 120.59 Feet
Found Nail & Tag #24622 north side power pole S35°W 66.38 Feet
Center of catch basin N40°W 40.33 Feet

This corner is accepted as a careful and faithful perpetuation of the position of the original corner.

Set by William G. Tingley Date 3/18/98 Surveyor's Michigan License No. 30104

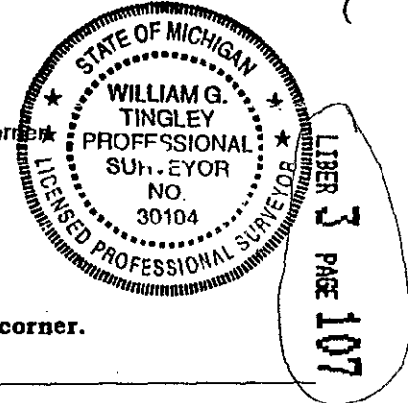

380/381