

LAND CORNER RECORDATION CERTIFICATE

Filing Requirement of Act 74, Mich. P.A. 1970

STATE OF MICHIGAN  
GRATIOT COUNTY  
RECORDED

22 JUL 99 11:55 A.M.

JANET M. DAVIS  
REGISTER OF DEEDS

Register of Deeds Stamp & File Number

For corners in  
GRATIOT  
(County)

Located In:

Corner Code #

WASHINGTON TWP.

1. Public Land Survey

T	9N	R	2W
T		R	
T		R	
T		R	
S		R	
S		R	
S		R	
S		R	

D-2

2. Property Controlling  
in Section

3. Miscellaneous  
Property in Sec.

4. Lot No. \_\_\_\_\_, Recorded Plat \_\_\_\_\_

5. Private Claims \_\_\_\_\_

	A	B	C	D	E	F	G	H	I	J	K	L	M
1													
2	6	5	4	3	2	1							
3													
4	7	8	9	10	11	12							
5													
6	18	17	16	15	14	13							
7													
8	19	20	21	22	23	24							
9													
10	30	29	28	27	26	25							
11													
12	31	32	33	34	35	36							
13													

I, DAVID R. LOHR, in a field survey on JULY 2, 1999,  
do hereby certify that under requirements of P.A. 74, Michigan P.A. of 1970, the corner points mentioned  
in lines 1 and 2 above were in conformance with regulations and rules therefore as required in the  
current manual of survey instructions of the United States Department of the Interior, Bureau of Land  
Management or by a decree of a Court of Law and/or that the corner points mentioned in lines 3, 4 and 5  
above were in conformance with the rules of the Michigan Board of Land Surveyors or by a Decree of a  
Court of Law; established, re-established, monumented, re-monumented, recovered, found as  
expressed below:

NOTE: Not more than 2 corners, all in the same town and range, may be recorded  
on this certificate.

A. Description of original monument and accessories and/or subsequent restoration:

1. CORNER NOT SET IN GLO SURVEY.

2. CORNER REFERENCED IN SURVEY BY R.J. FRAKER, COUNTY SURVEYOR, DATED DEC. 1877 ON PAGE 114 OF "SURVEY  
FIELD BOOKS - T9N, R2W" ON FILE AT GRATIOT COUNTY REGISTER OF DEEDS. "OAK POST " WITNESSED BY:  
H. ELM 16", S 75 E, 15 1/2 L (10.23')  
BEECH 6", S 11 W, .7 CH (46.20')  
SURVEY SHOWS DISTANCE NORTH OF 38.10 CH. (2514.60'), SOUTH OF 39.80 (2626.8'), EAST OF 39.72  
CH. (2621.52') AND WEST OF 39.86 CH. (2630.76').

3. NO OTHER REFERENCES FOUND.

B. Description of corner evidence found and/or method applied in restoring or reestablishing corner:  
SEARCHED AT APPARENT LOCATION OF CORNER AND FOUND 12" (305mm) WOODEN ANCHOR POST ON FENCELINE TO SOUTH.  
SET TRAVERSE POINT #1348 (#4 REBAR) AT NORTH SIDE OF ANCHOR POST AND TRAVERSED ENTIRE SECTION TO  
DETERMINE INTERSECTION OF 1/4 LINES. FOUND TRAVERSE POINT TO LIE 0.68 FT. (207mm) EAST X 5.16  
FT. (1.573m) NORTH OF INTERSECTION OF 1/4 LINES. LOCATION BASED ON PROPORTION USING FRAKER'S 1877  
DISTANCES FALLS 0.77 FT. (235mm) EAST X 3.06 FT. (.933m) SOUTH OF TRAVERSE POINT. NO EXCAVATION PERFORMED  
OTHER THAN TO SET STANDARD REMON. PIPE. SET STANDARD GRATIOT COUNTY REMONUMENTATION PIPE WITH BRASS CAP  
AT INTERSECTION OF 1/4 LINES ON NORTH-SOUTH FENCELINE, SURROUNDED BY STONES WITH FLAT STONE ON TOP.  
ACCEPTED BY THE GRATIOT COUNTY SURVEY PEER  
GROUP AS THE OFFICIAL CORNER UNDER MICHIGAN  
PUBLIC ACT 345 OF 1990 AT A MEETING HELD 7/21/99

*WGTingley*  
William Tingley, PS, Chairman

C. Description of monument for corner and accessories established to perpetuate locating the position of the corner:  
D-2: TOWN 9 NORTH, RANGE 2 WEST, WASHINGTON TOWNSHIP, GRATIOT COUNTY. SET STANDARD GRATIOT COUNTY  
REMONUMENTATION PIPE WITH BRASS CAP AT INTERSECTION OF 1/4 LINES. WITNESSED BY:


TRAV. PT. #1348 (#4 REBAR), N 07° W, 5.16' ( 1.573m)  
SET N/T #30090, N/S 8" (200mm) ASH, S 76° E, 22.99' ( 7.007m)  
SET N/T #30090, W/S 6" (150mm) ASH, S 55° E, 54.28' (16.544m)  
SET N/T #30090, S/S 8" (200mm) ASH, S 80° E, 34.06' (10.381m)

BEARINGS GIVEN ARE MAGNETIC. STANDARD MONUMENTATION CONSISTS OF A BERNTSEN  
STAINLESS STEEL 30" (762mm) X 2 3/8" (0.65mm) PIPE WITH A BRASS CAP STAMPED  
"GRATIOT COUNTY REMONUMENTATION", P.S. #30090.

Signed by *David R. Lohr*

Date 7/19/99

Surveyor's Michigan License No. 30090

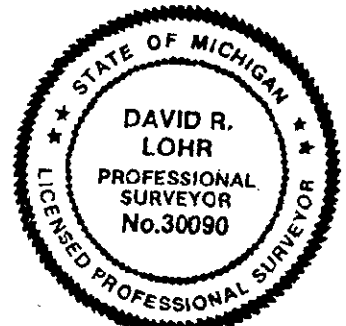

LIBER 3 PAGE 172