

MAR 23 1999

GRATIOT COUNTY REMONUMENTATION PROGRAM

GRATIOT CO. MICH. RECORDED

LAND CORNER RECORDATION CERTIFICATE

Filing Requirement of Act 74, Mich. P.A. 1970

'98 DEC 22 AM 10 54

SECTION

For corners in

Gratiot (County)	Located In: Township	Corner Code #
1. Public Land Survey	T 09N R 04W	J13
	T R	
	T R	
	T R	
2. Property Controlling in Section	S T R	
	S T R	
3. Miscellaneous Property in Sec.	S T R	
	S T R	

Janet M. Davis REGISTER OF DEEDS

Register of Deeds Stamp & File Number

- 4. Lot No. _____, Recorded Plat _____
- 5. Private Claims _____

	A	B	C	D	E	F	G	H	I	J	K	L	M
1													
2	6	5	4	3	2	1							
3													
4	7	8	9	10	11	12							
5													
6	18	17	16	15	14	13							
7													
8	19	20	21	22	23	24							
9													
10	30	29	28	27	26	25							
11													
12	31	32	33	34	35	36							
13													

I, William G. Tingley, in a field survey on 02/26/ 19 98, do hereby certify that under requirements of P.A. 74, Michigan P.A. of 1970, the corner points mentioned in lines 1 and 2 above were in conformance with regulations and rules therefore as required in the current manual of survey instructions of the United States Department of the Interior, Bureau of Land Management or by a decree of a Court of Law and/or that the corner points mentioned in lines 3, 4 and 5 above were in conformance with the rules of the Michigan Board of Land Surveyors or by a Decree of a Court of Law; established, re-established, monumented, re-monumented, recovered, found as expressed below:

NOTE: Not more than 2 corners, all in the same town and range, may be recorded on this certificate.

A. Description of original monument and accessories and/or subsequent restoration:
1883, Orange Risdon, Deputy Surveyor, G.L.O. Notes, Page 141.
 West on south boundary section 35
 40.00 set 1/4 section post

Sugar 6" N83.5°E 32 links
 Sugar 12" N50°W 6 Links

Record of Minutes of survey, D.W.A., Book A, Page 44
 Post 3x3

Elm 12" N51.5°W 92 Links
 R.Oak 8" S45°W 62.5 Links

12/19/1990, Tingley field notes for job #90535

Notes indicate that corner is located 2642.59 feet east of the southwest corner of section 35, 2641.11 feet west of the southeast corner of section 35, and on line between the two section corners.

10/18/1993, Pierson & Associates Sketch Showing Field Measurement Along County Line

Sketch indicates corner is 2642.64 feet east of the southwest corner of section 35, 2641.96 west of the southeast section corner of section 35, and 11.88 feet west of the section corner for township to the south (T08N-R04W-J01).

12/29/1993, Arden S. Pierson Registration #13039, L.C.R.C

Excavated 8'x8' area in road - Found 1/2" iron & cap #30104 Tingley.

1/2" rod & cap N 1/4 corner Section 2, T8N, R4W, -East- 11.88'
 Face 2" steel anchor post -N04°E- 30.85'
 SW corner telephone riser box -North- 30.82'

B. Description of corner evidence found and/or method applied in restoring or reestablishing corner. ACCEPTED BY THE GRATIOT COUNTY SURVEY PEER GROUP AS THE OFFICIAL CORNER UNDER MICHIGAN PUBLIC ACT 345 OF 1990 AT A MEETING HELD 3/18/98

Found 1/2" Tingley Iron and Cap 1' below surface.


Southwest corner telephone riser box N05°E 30.95 Feet
 Face 2" steel anchor post N10°E 31.82 Feet
 08-04-J01 S85°E 11.82 Feet

W.G.T.
 William Tingley, PS, Chairman

C. Description of monument for corner and accessories established to perpetuate locating the position of the corner.

Set standard remonumentation corner over Tingley Iron and Cap

Southwest corner telephone riser box N05°E 30.95 Feet
 Face 2" steel anchor post N10°E 31.82 Feet
 West end 12" Corrigated metal pipe S40°E 36.9 Feet
 East end 12" Corrigated metal pipe S61°E 62.15 Feet
 08-04-J01 S85°E 11.82 Feet

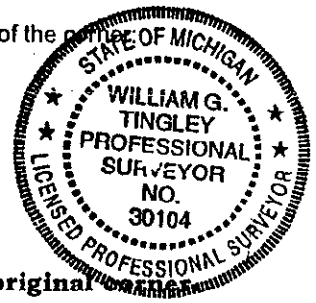

This corner is accepted as the best available evidence of the position of the original corner. Accessories to this corner approved by clinton county remon.

Signed by William G. Tingley Date 3/18/98

Surveyor's Michigan License No. 30104

386