

JAN 20 2000

GRATIOT COUNTY REMONUMENTATION PROGRAM

LAND CORNER RECORDATION CERTIFICATE

Filing Requirement of Act 74, Mich. P.A. 1970

STATE OF MICHIGAN
GRATIOT COUNTY
RECORDED

SECTION

11 JAN 2000 9:35 A.M.

JANET M. DAVIS
REGISTER OF DEEDS

For corners in

Gratiot
(County)

Located in:

Corner Code #

Hamilton Township

1. Public Land Survey	Sec 31 T 10 N R 1 W	✓ A-13, SW Corner
	Sec 36 T 10 N R 2 W	M-13
	Sec 6 T 9 N R 1 W	A-01
	Sec 1 T 9 N R 2 W	M-01
2. Property Controlling in Section	S T R	
	S T R	
3. Miscellaneous Property in Sec.	S T R	
	S T R	

Register of Deeds Stamp & File Number

- 4. Lot No. _____, Recorded Plat _____
- 5. Private Claims _____

I, William Tingley a field survey on September 12, 1996, do hereby certify that under requirements of P.A. 74, Michigan P.A. of 1970, the corner points mentioned in lines 1 and 2 above were in conformance with regulations and rules therefore as required in the current manual of survey instructions of the United States Department of the Interior, Bureau of Land Management or by a decree of a Court of Law and/or that the corner points mentioned in lines 3, 4 and 5 above were in conformance with the rules of the Michigan Board of Land Surveyors or by a Decree of a Court of Law; established, re-established, monumented, re-monumented, recovered, found as expressed below:

NOTE: Not more than 4 corners, all in the same town and range, may be recorded on this certificate.

A. Description of original monument and accessories and/or subsequent restoration:

1831, Robert Clark, Jr., Deputy Surveyor, GLO Notes
West on South boundary, Section 31, T10N-R1W 64.21 chains: Intersected West boundary at the end of 5 miles 79 chains 52 links

Beech 16" S28°E 28 links
Beech 8" N2-1/2°W 21 links

1872, D.W. Altenburg, County Surveyor, Liber B, Page 105, Record of Minutes of Survey

Post 2" x 2" Stone on post Old Town Corner Found
Swamp Elms 5" S23-1/2°W 76-1/2 links
Southeast Corner of Schoolhouse N51-3/4°W 196-1/2 links

1879, Thomas Harrod, Deputy County Surveyor, Liber B, Page 289, Record of Minutes of Survey

Refers to Liber B, Page 105 above
1955, Consumer Power Company Survey for Fee Title to Right-of-Way Strip
Found large stone. Set "T" iron. Old Wood stake slanted over stone.
Power Pole (nail on Southeast side) North Northwest 73.93 feet
Telephone Pole (nail in Northwest side) Southeast 34.69 feet
Road Sign Post Southwest 59.88 feet


ACCEPTED BY THE GRATIOT COUNTY SURVEYOR GROUP AS THE OFFICIAL CORNER UNDER MICHIGAN PUBLIC ACT 345 OF 1990 AT A MEETING HELD 11/30/99

B. Description of corner evidence found and/or method applied in restoring or reestablishing corner:

Found Iron in Monument box. Agree with Consumer Power Survey distances to West 1/4 and South 1/4 Section 31

C. Description of monument for corner and accessories established to perpetuate locating the position of the corner:

Set Remonumentation Monument in Monument Box.
Top Center Cable Riser Box N45°E 51.80 feet
Top Center Cable Riser Box S45°E 48.50 feet
Top Center Cable Riser Box N45°E 51.20 feet
Stop Sign Post S45°W 44.90 feet

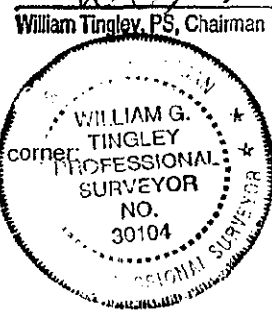

Signed by William Tingley Date 12/30, 1999

Surveyor's Michigan License No. 30104

FORM APPROVED BY MICHIGAN STATE BOARD OF LAND SURVEYORS, JAN. 21, 1971
REVISED MAY 14, 1976
REVISED JAN., 1983
ADAPTED FOR WORD PROCESSING MARCH, 1993

1	A	B	C	D	E	F	G	H	I	J	K	L	M
2		6	5	4	3	2	1						
3													
4		7	8	9	10	11	12						
5													
6		18	17	16	15	14	13						
7													
8		19	20	21	22	23	24						
9													
10		30	29	28	27	26	25						
11													
12		31	32	33	34	35	36						
13													