

GRATIOT COUNTY REMONUMENTATION PROGRAM
 LAND CORNER RECORDATION CERTIFICATE
 (Filing Requirement of Act 74, Mich. P.A. 1970)

GRATIOT CO. MICH.
 RECORDED

'96 DEC 26 AM 10 37

Janet M. Davis
 REGISTER OF DEEDS

For corners in
Gratiot
 (County)

Located in:
 Hamilton Township

Corner Code #

1. Public Land Survey Sec T 10N R F. 1W B-1 N 1/4
 T _____ R _____
 T _____ R _____
 T _____ R _____

2. Property Controlling in Section S _____ T _____ R _____
 S _____ T _____ R _____

3. Miscellaneous Property in Sec. S _____ T _____ R _____
 S _____ T _____ R _____

4. Lot No. _____, Recorded Plat _____

5. Private Claims _____

Register of Deeds Stamp & File Number

	A	B	C	D	E	F	G	H	I	J	K	L	M
1													
2	6	5	4	3	2	1							
3													
4	7	8	9	10	11	12							
5													
6	18	17	16	15	14	13							
7													
8	19	20	21	22	23	24							
9													
10	30	29	28	27	26	25							
11													
12	31	32	33	34	35	36							
13													

I, William Tingley a field surveyor on December 4, 1995

do hereby certify that under requirements of P.A. 74, Michigan P.A. of 1970, the corner points mentioned in lines 1 and 2 above were in conformance with regulations and rules therefore as required in the current manual of survey instructions of the United States Department of the Interior, Bureau of Land Management or by a decree of a Court of Law and/or that the corner points mentioned in lines 3, 4 and 5 above were in conformance with the rules of the Michigan Board of Land Surveyors or by a Decree of a Court of Law; established, re-established, monumented, re-monumented, recovered, found as expressed below:

NOTE: Not more than 4 corners, all in the same town and range, may be recorded on this certificate.


A. Description of original monument and accessories and/or subsequent restoration:
 Not Set GLO

1900, J.W. Harrod, County Surveyor, Field Book 10-1, Pages 24 and 25
 Stones - 1/4 Post T11N-R1W 120 links East
 Elm 16" 89 links S29°W

1968, No Surveyor given, Same Source
 Found Old Corner - Set Monument Box

No date, County Road Commission Record (probably D. Whittier)

Monument Box - 78.40 feet West of South 1/4 Section 31, T11N-R1W and 1394.05 feet East of Northwest Corner of Section 6
 Nail in Telephone Pole East Southeast 132.12 feet
 Nail in Telephone Pole West Southwest 276.30 feet

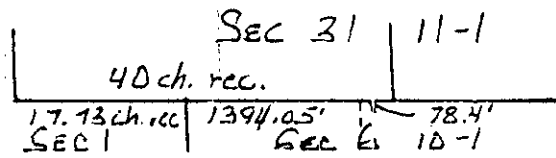


B. Description of corner evidence found and/or method applied in restoring or reestablishing corner:

Two feet below existing pavement and 78.40 feet West of South 1/4 of Section 31, Found Monument Box in Clay with 3/4" pipe over 1/2" pipe. Raised with 3/4" pipe in Monument Box to existing grade.

C. Description of monument for corner and accessories established to perpetuate locating the position of the corner:
 Set Remonumentation Monument over Pipe in Monument Box

- Top Center Orange Carsonite Witness Post N45°E 48.75 feet
 - Top Center Orange Carsonite Witness Post N45°W 40.40 feet
 - Top Center Orange Carsonite Witness Post S45°W 40.10 feet
 - Top Center Orange Carsonite Witness Post S45°E 53.30 feet
- 78.4 West of South 1/4 Post, Section 31, 11-1

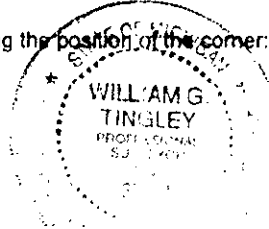

This position not established by original government surveyors. This monument is accepted as the best available evidence of the position of the corner.

Signed by William G. Tingley Date 12-17 1996

Surveyor's Michigan License No. 3 104

FORM APPROVED BY MICHIGAN STATE BOARD OF LAND SURVEYORS, JAN. 26, 1971

REVISED MAY 14, 1978
 REVISED JAN., 1983

ACCEPTED BY THE GRATIOT COUNTY SURVEY PEER GROUP AS THE OFFICIAL CORNER UNDER MICHIGAN PUBLIC ACT 345 OF 1990 AT A MEETING HELD 12-22-96

WGT.
 William Tingley, PS, Chairman