

MAY 05 1997

LAND CORNER RECORDATION CERTIFICATE
Filing Requirement of Act 74, Mich. P.A. 1970

GRATIOT CO. MICH.
RECORDED

'96 NOV 26 PM 2 34

For corners in COMMISSION
Gratiot
(County)

Located In: Hamilton Corner Code # _____

1. Public Land Survey Sec 6 T 10N R 1W C-1, N. Bndry
T _____ R _____
T _____ R _____
T _____ R _____

2. Property Controlling S _____ T _____ R _____
in Section S _____ T _____ R _____

3. Miscellaneous S _____ T _____ R _____
Property in Sec. S _____ T _____ R _____

4. Lot No. _____ Recorded Plat _____

5. Private Claims _____

Janet M. Davis
REGISTER OF DEEDS

Register of Deeds Stamp & File Number


	A	B	C	D	E	F	G	H	I	J	K	L	M
1													
2	6	5	4	3	2	1							
3													
4	7	8	9	10	11	12							
5													
6	18	17	16	15	14	13							
7													
8	19	20	21	22	23	24							
9													
10	30	29	28	27	26	25							
11													
12	31	32	33	34	35	36							
13													

I, William Tingley a field surveyor on December 6, 1995, do hereby certify that under requirements of P.A. 74, Michigan P.A. of 1970, the corner points mentioned in lines 1 and 2 above were in conformance with regulations and rules therefore as required in the current manual of survey instructions of the United States Department of the Interior, Bureau of Land Management or by a decree of a Court of Law and/or that the corner points mentioned in lines 3, 4 and 5 above were in conformance with the rules of the Michigan Board of Land Surveyors or by a Decree of a Court of Law; established, re-established, monumented, re-monumented, recovered, found as expressed below:

NOTE: Not more than 4 corners, all in the same town and range, may be recorded on this certificate.

A. Description of original monument and accessories and/or subsequent restoration:

- 1831, R. Thomas, Deputy Surveyor, GLO Notes
77.69 chains intersected North boundary line 84 links West at the post and set a post corner to Section 5 and 6
Elm 5" S51°E 22 links
Lynn 10" S18°W 24 links
- 1880, T.H. Harrod, Deputy Surveyor, Field Book 10-1, page 22 and 23
Oak 2" x 4" - Corner to 31 and 32 East 170 links (112.2 feet)
Old Corner Found
Oak 40" S20°W 137 links
Elm 14" S29°E 116 links
- 1900 J.W. Harrod, Deputy County Surveyor, Field Book, 10-1, Page 24 and 25
Old Corner Found
1" Pipe
Maple 8" S50-1/2°W 66-3/4 links (44.06 feet)
Elm 10" S25-1/2°E 68 links (44.88 feet)
- Also addition on Page (no surveyor name), 1968 Found Old Corner, Set Monument Box
No date, County Road Commission records
Power Pole Northwest 63.70 feet
Tree (Walnut) southwest 93.20 feet
112.23 feet West of Corner (T11N (Monument Box)
- 1973, J. Radcliff #11368, LCRC, Liber 2, Page 47
Found 1-1/4" Pipe in Monument Box
28" Elm S30°W 93.20 feet
Telephone Pole S80°E 42.0 feet
Power Pole N75°W 63.69 feet
- 1973, J. Radcliff #11368, Survey, Liber 1, Page 278
Same Corner description as LCRC

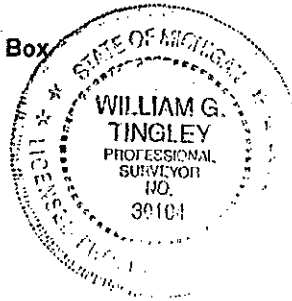

Continued on Back

B. Description of corner evidence found and/or method applied in restoring or reestablishing corner:

Found 3/4" iron pipe over greenstone 111.90 feet West of C-13 T11N-R1W
Stone 2 feet below surface with stone around. 6 feet North of Centerline of Washington Road, Centerline of McClelland Road South

C. Description of monument for corner and accessories established to perpetuate locating the position of the corner:

- Set Remonumentation Corner over Stone in Monument Box
Found Spike in 28" Walnut S35°W 92.94 feet
Found Nail in Eastside Power Pole N50°W 63.63 feet
Found P.K. Nail in Post S45°E 41.95 feet
Found P.K. Nail in Corner Fence Post S45°W 60.98 feet

ACCEPTED BY THE GRATIOT COUNTY SURVEY PEER GROUP AS THE OFFICIAL CORNER UNDER MICHIGAN PUBLIC ACT 345 OF 1990 AT A MEETING HELD 10/25/96

WGT
William Tingley, PS, Chairman

This corner is accepted as a careful and faithful perpetuation of the position of the original corner.

Signed by William Tingley Date 10/25/96

Surveyor's Michigan License No. 39104

1980, T.J. Mueller #25861, LCRC, Liber 1, Page 524

Pipe in Monument Box

West Leg of Road Sign	North	12.25 feet
Telephone Pole	Southeast	41.95 feet
15" Walnut	Southwest	94.14 feet

1981, T. Mueller, Survey, Liber 428, Page 1241

Same Corner description as LCRC