

MAY 05 1997

LAND CORNER RECORDATION CERTIFICATE

Filing Requirement of Act 74, Mich. P.A. 1970

'96 NOV 26 PM 2 33

Janet M. Davis REGISTER OF DEEDS

Register of Deeds Stamp & File Number

	A	B	C	D	E	F	G	H	I	J	K	L	M
1													
2	6	5	4	3	2	1							
3													
4	7	8	9	10	11	12							
5													
6	18	17	16	15	14	13							
7													
8	19	20	21	22	23	24							
9													
10	30	29	28	27	26	25							
11													
12	31	32	33	34	35	36							
13													

For commission in
Gratiot
 (County)

Located In: Hamilton Township

Corner Code #

1. Public Land Survey Sec 5 T 10N R 1W D-1, N 1/4
 T _____ R _____
 T _____ R _____
 T _____ R _____

2. Property Controlling in Section S _____ T _____ R _____
 S _____ T _____ R _____

3. Miscellaneous Property in Sec. S _____ T _____ R _____
 S _____ T _____ R _____

4. Lot No. _____, Recorded Plat _____

5. Private Claims _____

I, William Tingley a field surveyor on December 6, 1995, do hereby certify that under requirements of P.A. 74, Michigan P.A. of 1970, the corner points mentioned in lines 1 and 2 above were in conformance with regulations and rules therefore as required in the current manual of survey instructions of the United States Department of the Interior, Bureau of Land Management or by a decree of a Court of Law and/or that the corner points mentioned in lines 3, 4 and 5 above were in conformance with the rules of the Michigan Board of Land Surveyors or by a Decree of a Court of Law; established, re-established, monumented, re-monumented, recovered, found as expressed below:

NOTE: Not more than 4 corners, all in the same town and range, may be recorded on this certificate.

A. Description of original monument and accessories and/or subsequent restoration:
 Not Set GLO

1880, T.H. Harrod, Deputy Surveyor, Field Book 10-1, Page 22-23

- Black Ash 4" x 4"
- Elm 24" S29-1/2°W 72 links
- Oak 3" S46-1/4°E 54 links

Liber C, page 46, Record of Minutes of Survey has same record

1980, T.J. Mueller #25861, LCRC, Liber 1, pages 524

Found Pipe in Monument Box

No accessories available

1981, T.J. Mueller, Survey, Liber 426, Page 1241

Same as LCRC, Liber 1, Page 524

Gratiot County Road Commission Road Plans

4.3 feet North of P.I. and 80 feet West of 1/4 Corner, Section 32

B. Description of corner evidence found and/or method applied in restoring or reestablishing corner:
 Found a 1" x 1.7 feet Iron Pipe in Monument Box on a 1" to 4" Reducing Cap which sets over a 2" pipe and remains of wood stake. A second 2" iron pipe is at the Northside of first. Also a 1" x 8" shaft at the Eastside of first 2" Iron Pipe. Found 2 large stones West and South on 2" pipes in gray clay.

C. Description of monument for corner and accessories established to perpetuate locating the position of the corner:


Set Remonumentation Monument over remains of wood stake and 2 inch Iron Pipe.

- Centerline Telephone Box S50°W 61.82 feet
- Nail & Tag in West Cedar Fence N60°E 88.05 feet
- Bolt in Southside Wood Post (with electric Box S75°E 150.79 feet
- Found Nail & Tag in Southwest Side Power Pole W70°E 141.23 feet
- South 1/4 Corner, Section 32, T11N-R1W East 79.75 feet

This corner is accepted as a careful and faithful perpetuation of the position of the original corner.

Signed by William Tingley Date 10/15, 1996

Surveyor's Michigan License No. 30104

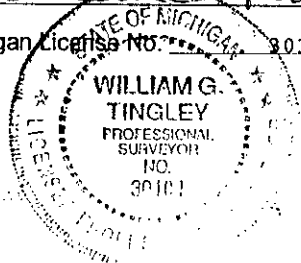

FORM APPROVED BY MICHIGAN STATE BOARD OF LAND SURVEYORS, JAN. 28, 1971
 REVISED MAY 14, 1976
 REVISED JAN., 1983
 ADAPTED FOR WORD PROCESSING MARCH, 1993

ACCEPTED BY THE GRATIOT COUNTY SURVEY PEER GROUP AS THE OFFICIAL CORNER UNDER MICHIGAN PUBLIC ACT 345 OF 1990 AT A MEETING HELD 10/15/96

WGT
 William Tingley, PS, Chairman