

SURVEY & REMONUMENTATION GRATIOT COUNTY REMONUMENTATION PROGRAM

LIBER 562 PAGE 1316

GRATIOT CO. MICH.

RECORDED

MAY 05 1997

LAND CORNER RECORDATION CERTIFICATE

Filing Requirement of Act 74, Mich. P.A. 1970

'96 NOV 26 PM 2 34

For corners in **COMMISSION**

Gratiot (County) Located In: Hamilton Corner Code #

1. Public Land Survey Sec 4 T 10 N R 1 W E-1, Sec Corner
 T R
 T R
 T R

2. Property Controlling in Section S T R
 S T R

3. Miscellaneous Property in Sec. S T R
 S T R

Janet M. Davis
REGISTER OF DEEDS

Register of Deeds Stamp & File Number

4. Lot No. _____ Recorded Plat _____
 5. Private Claims _____

I, William Tingley a field survey on December 5, 1995

do hereby certify that under requirements of P.A. 74, Michigan P.A. of 1970, the corner points mentioned in lines 1 and 2 above were in conformance with regulations and rules therefore as required in the current manual of survey instructions of the United States Department of the Interior, Bureau of Land Management or by a decree of a Court of Law and/or that the corner points mentioned in lines 3, 4 and 5 above were in conformance with the rules of the Michigan Board of Land Surveyors or by a Decree of a Court of Law; established, re-established, monumented, re-monumented, recovered, found as expressed below:

	A	B	C	D	E	F	G	H	I	J	K	L	M
1													
2	6		5		4		3		2		1		
3													
4	7		8		9		10		11		12		
5													
6	18		17		16		15		14		13		
7													
8	19		20		21		22		23		24		
9													
10	30		29		28		27		26		25		
11													
12	31		32		33		34		35		36		
13													

NOTE: Not more than 4 corners, all in the same town and range, may be recorded on this certificate.

A. Description of original monument and accessories and/or subsequent restoration:

- 1831, R. Thomas, Deputy Surveyor, GLO Notes
77.30 chains; intersected North boundary 67 links West of Post and set a post corner to Section 4 and 5
- 1880, T.H. Harrod, Deputy Surveyor, Field Book 10-2, Page 22-23
3" x 3" Red Oak - Old Corner Found
 Corner to 32 and 33 East 69 links
 Black Ash 36" S24-1/2°W 66-1/2 links
 Elm 6" S45°W 86 links
- 1906, E.W. Redman, Field Book 10-1, Pages 20-21
Old Corner Found - Plowpoint and stones
 Corner 32 and 33 East 69 links
 Plowpoint N32°E 43 links
- No date
 Telephone Pole Southeast 56 feet
 Telephone Pole Northeast 80 feet
- 1947, Gratiot County Road Commission
 Channel shaped bar 1" wide 10 deep
 24" White Oak North about 80°W 249.3 feet
 Center West End 18" corrugated Tube under Road to North, 32.8 feet
 Gratiot County Road Plans, Corner 4 & 5 of
 0.51 feet North of P.I.

B. Description of corner evidence found and/or method applied in restoring or reestablishing corner:


Found 1" pipe in Monument Box. At 2 feet below surface found that pipe was in remains of old wood stake with stones around. 1 foot North of Centerline East-West Road and 3 feet West of Centerline of Road south (bituminous pavement) 46.90 feet West of corner 32-33 T11N-R1W

C. Description of monument for corner and accessories established to perpetuate locating the position of the corner:

- Set Remonumentation Monument over Pipe in Monument Box
 North corner Concrete Project Marker S20°E 74.62 feet
 Set Nail and Tag in 8" Wood Post Cable Marker S40°W 60.25 feet
 West End 15" CMP Culvert N45°E 36.48 feet
 Southwest Corner Southend Curb on Westside of Ransom Road S20°W 65.02 feet

Signed by William G. Tingley Date 10/15/96

Surveyor's Michigan License No. 30104

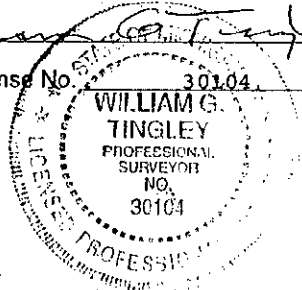

FORM APPROVED BY MICHIGAN STATE BOARD OF LAND SURVEYORS, JAN. 28, 1971

REVISED MAY 14, 1975
REVISED JAN., 1983
ADAPTED FOR WORD PROCESSING MARCH, 1993

ACCEPTED BY THE GRATIOT COUNTY SURVEY PEER GROUP AS THE OFFICIAL CORNER UNDER MICHIGAN PUBLIC ACT 345 OF 1990 AT A MEETING HELD 10/15/96

WGT.
William Tingley, PS, Chairman