

SURVEY & REMONUMENTATION

LIBER 563 PAGE 1116

SEP 08 1999

**GRATIOT COUNTY REMONUMENTATION PROGRAM
LAND CORNER RECORDATION CERTIFICATE
Filing Requirement of Act 74, Mich. P.A. 1970**

GRATIOT CO. MICH.
RECORDED

'96 DEC 26 AM 10 37

SECTION

For corners in Gratiot Located in: North Star Township Corner Code # _____
(County)

1. Public Land Survey Sec 4 T 10 N R 2 W R-1, N 1/4
T _____ R _____
T _____ R _____
T _____ R _____

2. Property Controlling in Section S _____ T _____ R _____
S _____ T _____ R _____

3. Miscellaneous Property in Sec. S _____ T _____ R _____
S _____ T _____ R _____

4. Lot No. _____ Recorded Plat _____

5. Private Claims _____

Janet M. Jones
REGISTER OF DEEDS

Register of Deeds Stamp & File Number

1	A	B	C	D	E	F	G	H	I	J	K	L	M
2	6	5	4	3	2	1							
3													
4	7	8	9	10	11	12							
5													
6	18	17	16	15	14	13							
7													
8	19	20	21	22	23	24							
9													
10	30	29	28	27	26	25							
11													
12	31	32	33	34	35	36							
13													

I, William Tingley a field surveyor on November 20, 1995, do hereby certify that under requirements of P.A. 74, Michigan P.A. of 1970, the corner points mentioned in lines 1 and 2 above were in conformance with regulations and rules therefore as required in the current manual of survey instructions of the United States Department of the Interior, Bureau of Land Management or by a decree of a Court of Law and/or that the corner points mentioned in lines 3, 4 and 5 above were in conformance with the rules of the Michigan Board of Land Surveyors or by a Decree of a Court of Law; established, re-established, monumented, re-monumented, recovered, found as expressed below:

NOTE: Not more than 2 corners, all in the same town and range, may be recorded on this certificate.

A. Description of original monument and accessories and/or subsequent restoration:
Not set GLO

1880, T.H. Harrod, Deputy Surveyor, Field Book 10-2, Pages 96-97
Ironwood 5" x 5" Corner
Elm Stump 36" N74-1/2°E 49-1-1/2 links
Liber C, Page 50 Record of Minutes of Survey
Has same record


B. Description of corner evidence found and/or method applied in restoring or reestablishing corner:
5/8" Rod in pipe in Monument Box. At 18" deep found 3/4" Iron Pipe drive in 2" x 4" Wood Post between two large stones and 5/8" Rod driven in pipe. On field line South and Centerline 20 feet bituminous pavement East and West.

C. Description of monument for corner and accessories established to perpetuate locating the position of the corner:
Set Remonumentation Monument over Rod & Pipe
Set P.K. Nail Northwest Side Power Pole N55°E 90.89 feet
Set P.K. South Side Telephone Pole S70°W 202.38 feet
Set P.K. North Side Power Pole N65°W 210.00 feet
Centerline Telephone Box S45°W 43.58 feet

This position not established by original government surveyors. This monument is accepted as the best available evidence of the position of the corner.

Signed by William Tingley Date 12-17-1996
Surveyor's Michigan License No. 30104


FORM APPROVED BY MICHIGAN STATE BOARD OF LAND SURVEYORS, JAN. 26, 1971
REVISED MAY 14, 1978
REVISED JAN., 1985
ADAPTED FOR WORD PROCESSING MARCH, 1989

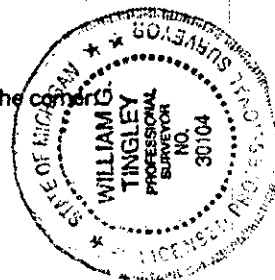

WGT
William Tingley, PS, Chairman

SEC 33 11-2

SEC 34 11-2

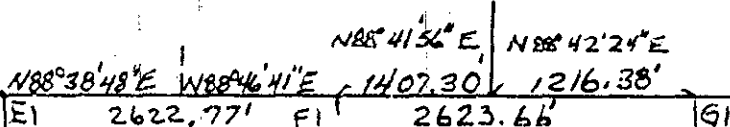

Sec. 4 10-2