

MAY 05 1997

LAND CORNER RECORDATION CERTIFICATE

RECORDED

Filing Requirement of Act 74, Mich. P.A. 1970

'96 NOV 26 PM 2 33

COMMISSION

For corners in Gratiot Located In: North Star Corner Code # K-9, Sec. Corner
 (County)

1. Public Land Survey Sec T 10N R 2W
 T _____ R _____
 T _____ R _____
 T _____ R _____

2. Property Controlling S _____ T _____ R _____
 in Section S _____ T _____ R _____

3. Miscellaneous S _____ T _____ R _____
 Property in Sec. S _____ T _____ R _____

Janet M. Davis REGISTER OF DEEDS

Register of Deeds Stamp & File Number

4. Lot No. _____, Recorded Plat _____
 5. Private Claims _____


1	A	B	C	D	E	F	G	H	I	J	K	L	M
2	6	5	4	3	2	1							
3													
4	7	8	9	10	11	12							
5													
6	18	17	16	15	14	13							
7													
8	19	20	21	22	23	24							
9													
10	30	29	28	27	26	25							
11													
12	31	32	33	34	35	36							
13													

I, William Tingley a field surveyor on August 27, 1996
 do hereby certify that under requirements of P.A. 74, Michigan P.A. of 1970, the corner points mentioned in lines 1 and 2 above were in conformance with regulations and rules therefore as required in the current manual of survey instructions of the United States Department of the Interior, Bureau of Land Management or by a decree of a Court of Law and/or that the corner points mentioned in lines 3, 4 and 5 above were in conformance with the rules of the Michigan Board of Land Surveyors or by a Decree of a Court of Law; established, re-established, monumented, re-monumented, recovered, found as expressed below:

NOTE: Not more than 4 corners, all in the same town and range, may be recorded on this certificate.

- A. Description of original monument and accessories and/or subsequent restoration:
 1852, Austin Burt, Deputy Surveyor, GLO Notes
 Corrected S11°E on old line. 79.90 (chains). Old corner Sections 23, 24, 25 and 26 (Resurvey of 10-2).
 1871, D. Altenburg, County Surveyor, Liber 5, Page 288, Record of Minutes of Survey
 2" x 2" Post Corner
 Black Ash 18" S10°W 65-1/2 links
 Black Ash 4" N25-1/2°W 48 links -- old corner found
 1887, Parker Merrill, County Surveyor
 Old corner set for Section 25
 1902, J. Harrod, County Surveyor, Liber C page 165, Record of Minutes of Survey
 Same bearing trees as above
 1972, D. Whittier #10020, LCRC, Liber 1, Page 177
 Found 4" x 6" x 28" stone. Set 1" Pipe on Northside
 Nail in Westside 36" Maple S45°E 69.42 feet
 Nail in Eastside Telephone Pole S45°W 41.65 feet
 Nail in Eastside Post N45°W 37.60 feet
 1996, William Tingley #30104, Survey #96323
 Found 1" Iron Pipe by Stone
 Found Nail and Tag North Side 42" Maple S30°E 69.12 feet
 Set Nail and Tag Southeast side Power Pole S55°W 267.82 feet
 Set Nail and Tag South side Power Pole N80°W 201.58 feet
 Set Nail and Tag Westside Power Pole N12°E 205.98 feet

- B. Description of corner evidence found and/or method applied in restoring or reestablishing corner:
 Found 1" pipe by stone; set P.K. Nail, Center of Pipe
 Found Nail and Tag 14769 Northside 42" Maple S30°E 69.12 feet
- C. Description of monument for corner and accessories established to perpetuate locating the position of the corner:
 Set Remonumentation Monument over Pipe
 Found Nail and Tag North Side 42" Maple S30°E 69.12 feet
 Set Nail and Tag Southeast side Power Pole S55°W 267.82 feet
 Set Nail and Tag South Side Power Pole N80°W 201.58 feet
 Set Nail and Tag West Side Power Pole N12°E 205.98 feet

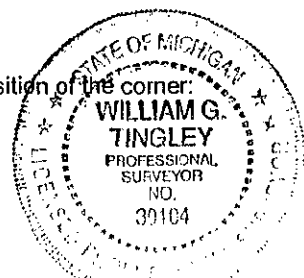

This corner is accepted as a careful and faithful perpetuation of the position of the original corner.

Signed by William G. Tingley Date 10/15 1996

Surveyor's Michigan License No. 30104

FORM APPROVED BY MICHIGAN STATE BOARD OF LAND SURVEYORS, JAN. 28, 1971
 REVISED MAY 14, 1975
 REVISED JAN., 1983
 ADAPTED FOR WORD PROCESSING MARCH, 1993

ACCEPTED BY THE GRATIOT COUNTY SURVEY PERS. GROUP AS THE OFFICIAL CORNER UNDER MICHIGAN PUBLIC ACT 345 OF 1990 AT A MEETING HELD 10/15/96

WGT
 William Tingley, PS, Chairman