

**SURVEY &
REMONUMENTATION**

1993

LAND CORNER RECORDATION CERTIFICATE

Filing Requirement of Act 74, Mich. P.A. 1970

Gratiot County Remonumentation Program

GRATIOT CO. MICH,
RECORDED

'93 DEC 20 PM 12 24

For corners in COMMISSION
GRATIOT
(County)

Located In: Corner Code #

1. Public Land Survey Sec. 6 T 10 R 4 B-1 N 1/4
 T _____ R _____
 T _____ R _____
 T _____ R _____
2. Property Controlling in Section S _____ T _____ R _____
 S _____ T _____ R _____
3. Miscellaneous Property in Sec. S _____ T _____ R _____
 S _____ T _____ R _____

Janet M. Davis
REGISTER OF DEEDS

Register of Deeds Stamp & File Number

4. Lot No. _____, Recorded Plat _____
 5. Private Claims _____

I, William Tingley a field survey on October 23, 1993, do hereby certify that under requirements of P.A. 74, Michigan P.A. of 1970, the corner points mentioned in lines 1 and 2 above were in conformance with regulations and rules therefore as required in the current manual of survey instructions of the United States Department of the Interior, Bureau of Land Management or by a decree of a Court of Law and/or that the corner points mentioned in lines 3, 4 and 5 above were in conformance with the rules of the Michigan Board of Land Surveyors or by a Decree of a Court of Law; established, re-established, monumented, re-monumented, recovered, found as expressed below:

	A	B	C	D	E	F	G	H	I	J	K	L	M
1													
2	6	5	4	3	2	1							
3													
4	7	8	9	10	11	12							
5													
6	18	17	16	15	14	13							
7													
8	19	20	21	22	23	24							
9													
10	30	29	28	27	26	25							
11													
12	31	32	33	34	35	36							
13													

NOTE: Not more than 4 corners, all in the same town and range, may be recorded on this certificate.

A. Description of original monument and accessories and/or subsequent restoration:
 Corner not set by GLO.

October 30 and 31, 1893, D.W. Altenburg, County Surveyor, Book A, Page 56 from Record of Minutes of Surveys in Gratiot County Road Commission

- Set corner with 3 x 3 cedar post
- Oak Stump South 41 links
- Elm Stump 10" Northwest 32-1/2 links
- Pine Stump 30" S5-1/2°E 1.06 chains
- Post - Section Corner Section 31 & 32 T11N R4W East 3.46-1/2 chains

July 24, 1978 Jerry Jones #19838 in Liber 1 page 438 of Land Corner Recordation Book at Gratiot County Drain Commission Found 3/4" Pipe


B. Description of corner evidence found and/or method applied in restoring or reestablishing corner:
 Found 3/4" Pipe in mon box.

C. Description of monument for corner and accessories established to perpetuate locating the position of the corner:
 Set remonumentation and mon box

- Nail and tag Northwest side Power Pole N30°W 59.6'
- Southeast corner Garage #11086, Countyline Road 555 N25°W 124.3'
- Nail and Tag Southeast side Power Pole, S55°W 86.6'
- Section Corner 31 and 32 T11N R4W East 228.8'
- Monument box is 1 foot North of Centerline

This corner is accepted as a careful and faithful perpetuation of the position of the original corner.

Signed by William G. Tingley Date November 30 1993
 Surveyor's Michigan License No. 30104

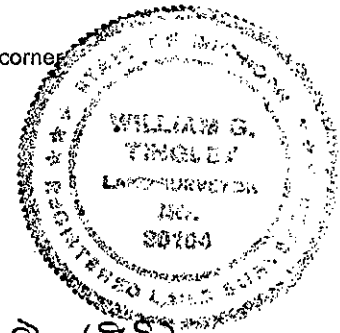

FORM APPROVED BY MICHIGAN STATE BOARD OF LAND SURVEYORS, JAN. 28, 1971
 REVISED MAY 14, 1975
 REVISED JAN., 1983
 ADAPTED FOR WORD PROCESSING MARCH, 1993