

1993

COMMISSION

LAND CORNER RECORDATION CERTIFICATE

Filing Requirement of Act 74, Mich. P.A. 1970

GRATIOT CO. MICH. RECORDED

'93 DEC 20 PM 12 24

For corners in Gratiot (County)

Gratiot County Remonumentation Program

Located In: Corner Code #

- 1. Public Land Survey Sec. 6 T\_10 R\_4 C-1, NE corner
2. Property Controlling in Section
3. Miscellaneous Property in Sec.

Janet M. Davis REGISTER OF DEEDS

Register of Deeds Stamp & File Number

- 4. Lot No. Recorded Plat
5. Private Claims

Grid table with columns A-M and rows 1-13. Cell (1,3) is marked with a dot.

I, William Tingley, in a field survey on October 30, 1993, do hereby certify that under requirements of P.A. 74, Michigan P.A. of 1970, the corner points mentioned in lines 1 and 2 above were in conformance with regulations and rules therefore as required in the current manual of survey instructions of the United States Department of the Interior, Bureau of Land Management or by a decree of a Court of Law and/or that the corner points mentioned in lines 3, 4 and 5 above were in conformance with the rules of the Michigan Board of Land Surveyors or by a Decree of a Court of Law; established, re-established, monumented, re-monumented, recovered, found as expressed below:

NOTE: Not more than 4 corners, all in the same town and range, may be recorded on this certificate.

A. Description of original monument and accessories and/or subsequent restoration: December 6, 1831 Orange Risdon, Deputy Surveyor, intersected North boundary 3.62 links West of quarter section post. (Sec. 32 T11N R4W) Set post corner Sections 5 and 6. W. Oak 16" S37°E 37 chains Beech 14" S58°W 70 chains May, 1874 D.W. Altenburg, County Surveyor, Book B, page 37 from Record of Minutes of Survey of Gratiot County Road Commission October 30 and 31, 1893, D.W. Altenburg, County Surveyor, Book A, page 56 from Record of Minutes of Survey of Gratiot County Road Commission Found stone and plow point Elm 10" S79-1/2°E 1 chain 65 links 3" post S 5 links Elm 12" Southeast 95 links March 24, 1979 Richard J. Crater #16924, Liber 1, Page 457 of Land Corner Recordation Book Found rered beneath blacktop, 1.33 feet South of township line. Set no monument on corner.


B. Description of corner evidence found and/or method applied in restoring or reestablishing corner:

Accepted as corner. Found rered beneath blacktop 1.33 feet South of township line by Richard J. Crater #16924, Liber 1, Page 457 of Land Corner Recordation Book.

C. Description of monument for corner and accessories established to perpetuate locating the position of the corner:

Set remonumentation corner in mon box South 1.33' South of township line. South 1/4 corner section 32 T11N R4W is East 238.92' Set nail and tag northwest side of power pole, S20°E, 71.60' Set nail and tag southeast side 12" oak, N45°E, 68.18' Set nail and tag northeast side power pole S50°E, 166.5'

This corner is accepted as a careful and faithful perpetuation of the position of the original corner.

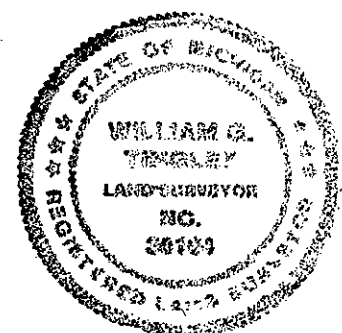

Signed by William O. Tingley Date November 30, 1993

Surveyor's Michigan License No. 30104