

FEB 22 1996

GRATIOT COUNTY REMONUMENTATION PROGRAM  
LAND CORNER RECORDATION CERTIFICATE  
Filing Requirement of Act 74, Mich. P.A. 1970

GRATIOT CO. MICH.  
RECORDED

'95 DEC 20 PM 1 29

For corners in  
Gratiot  
(County)

Located In:  
New Haven Township

Corner Code #

1. Public Land Survey Sec. 2 T 10 N R 4 W J-1, N 1/4  
T \_\_\_\_\_ R \_\_\_\_\_  
T \_\_\_\_\_ R \_\_\_\_\_  
T \_\_\_\_\_ R \_\_\_\_\_

2. Property Controlling S \_\_\_\_\_ T \_\_\_\_\_ R \_\_\_\_\_  
in Section S \_\_\_\_\_ T \_\_\_\_\_ R \_\_\_\_\_

3. Miscellaneous S \_\_\_\_\_ T \_\_\_\_\_ R \_\_\_\_\_  
Property in Sec. S \_\_\_\_\_ T \_\_\_\_\_ R \_\_\_\_\_

4. Lot No. \_\_\_\_\_, Recorded Plat \_\_\_\_\_

5. Private Claims \_\_\_\_\_

*Janet M. Davis*  
REGISTER OF DEEDS

Register of Deeds Stamp & File Number

I, William Tingley, in a field survey on February 27 19 95, do hereby certify that under requirements of P.A. 74, Michigan P.A. of 1970, the corner points mentioned in lines 1 and 2 above were in conformance with regulations and rules therefore as required in the current manual of survey instructions of the United States Department of the Interior, Bureau of Land Management or by a decree of a Court of Law and/or that the corner points mentioned in lines 3, 4 and 5 above were in conformance with the rules of the Michigan Board of Land Surveyors or by a Decree of a Court of Law; established, re-established, monumented, re-monumented, recovered, found as expressed below:

	A	B	C	D	E	F	G	H	I	J	K	L	M
1													
2	6	5	4	3	2	1							
3													
4	7	8	9	10	11	12							
5													
6	18	17	16	15	14	13							
7													
8	19	20	21	22	23	24							
9													
10	30	29	28	27	26	25							
11													
12	31	32	33	34	35	36							
13													

NOTE: Not more than 4 corners, all in the same town and range, may be recorded on this certificate.

A. Description of original monument and accessories and/or subsequent restoration:  
Corner was not set, no GLO notes.

April 20 and 21, 1880 Thomas H. Harrod, Deputy County Surveyor, Book C, page 43, from Record of Minutes of Survey in Gratiot County Drain Commission  
Set Cedar Post and Plow Point  
Cherry 3" S42°W 1.06 chains

B. Description of corner evidence found and/or method applied in restoring or reestablishing corner:  
Found iron in mon box 281.82 feet West of 35-36 T11N-R4W as shown in Harrod's 1880 notes  
Centerline Olsen Road South

ACCEPTED BY THE GRATIOT COUNTY SURVEY PEER GROUP AS THE OFFICIAL CORNER UNDER MICHIGAN PUBLIC ACT 345 OF 1990 AT A MEETING HELD 11-29-95


*WGT*  
William Tingley, PS, Chairman

C. Description of monument for corner and accessories established to perpetuate locating the position of the corner:  
Set remonumentation corner and mon box.

- Nail and tag Northside Power Pole S60°W 191.40 feet
- Nail and tag in Southside Power Pole N60°W 190.35 feet
- Top Center Phone Box N45°W 48.5 feet

Corner Sections 35 & 36, T11N R4W, 281.82 feet East, approved by Remonumentation Peer Group (Liber

This corner is accepted as the best available evidence of the position of the original corner.

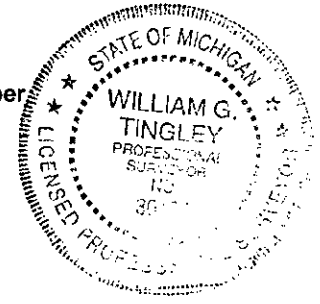

Signed by *William Tingley* Date 12-12-1995

Surveyor's Michigan License No. 30104