

SURVEY & REMONUMENTATION

LIBER **551** PAGE **996**

SEP 08 1999

GRATIOT COUNTY REMONUMENTATION PROGRAM

LAND CORNER RECORDATION CERTIFICATE

GRATIOT CO. MICH.

RECORDED

SECTION

Filing Requirement of Act 74, Mich. P.A. 1970

'95 DEC 20 PM 1 28

For corners in

<u>Gratiot</u>	Located In:	Corner Code #
(County)		
	Emerson Township	
1. Public Land Survey	Sec 19 T <u>11</u> N R <u>2</u> W	<u>A-9, W. Bdry</u>
	T _____ R _____	_____
	T _____ R _____	_____
	T _____ R _____	_____
2. Property Controlling in Section	S _____ T _____ R _____	_____
	S _____ T _____ R _____	_____
3. Miscellaneous Property in Sec.	S _____ T _____ R _____	_____
	S _____ T _____ R _____	_____

Janet M. Davis
REGISTER OF DEEDS

Register of Deeds Stamp & File Number

4. Lot No. _____, Recorded Plat _____
5. Private Claims _____

	A	B	C	D	E	F	G	H	I	J	K	L	M
2	6	5	4	3	2	1							
3													
4	7	8	9	10	11	12							
5													
6	18	17	16	15	14	13							
7													
8	19	20	21	22	23	24							
9													
10	30	29	28	27	26	25							
11													
12	31	32	33	34	35	36							
13													

I, William Tingley a field survey on September 5, 1995, do hereby certify that under requirements of P.A. 74, Michigan P.A. of 1970, the corner points mentioned in lines 1 and 2 above were in conformance with regulations and rules therefore as required in the current manual of survey instructions of the United States Department of the Interior, Bureau of Land Management or by a decree of a Court of Law and/or that the corner points mentioned in lines 3, 4 and 5 above were in conformance with the rules of the Michigan Board of Land Surveyors or by a Decree of a Court of Law; established, re-established, monumented, re-monumented, recovered, found as expressed below:

NOTE: Not more than 4 corners, all in the same town and range, may be recorded on this certificate.

A. Description of original monument and accessories and/or subsequent restoration:

1852, Austin Burt, Deputy Surveyor, GLO Notes, Resurvey
1862, S. Hastings, County Surveyor

1-1/4" Pipe 20" Long at 20 links East of Section line
Elm 14" N72-1/2°E 124-1/2 links
Apple N50°W 100 links
66 links North Arcada Corner

1931, Michigan State Highway Department construction plans, U.S. -27, Emerson Corner Station 79+58.4

Section Cornerstone
Maple 12" Southeast 44.8 feet
Elm 12" South 37.3 feet
Apple 12" Northwest 35.7 feet
On Centerline Polk Road (East)
Arcada Corner South 43.56 feet

ACCEPTED BY THE GRATIOT COUNTY SURVEY PEER GROUP AS THE OFFICIAL CORNER UNDER MICHIGAN PUBLIC ACT 345 OF 1990 AT A MEETING HELD 11-29-95


WGT
William Tingley, PS, Chairman

1961, Michigan State Highway Department
Monument Box - stone
1978, J. Jones, #19838, Survey, Liber 418, Page 54
Found Monument Box

B. Description of corner evidence found and/or method applied in restoring or reestablishing corner:
Found 1" pipe in Monument Box. Dug through Monument Box and found remon and decayed wood below.

C. Description of monument for corner and accessories established to perpetuate locating the position of the corner:

Set Remonumentation Corner over Wood Stake in Monument Box
On project of Centerline of old road grade East
Found Nail & MSHD tag in Power Pole N35°W 46.90 feet
Found Nail & Brass Tag in Power Pole N40°E 63.25 feet
Found Nail and #14769 tag in Power Pole S40°W 85.50 feet
Set Nail and Tag 30104 in 7" Maple S40°E 104.20 feet

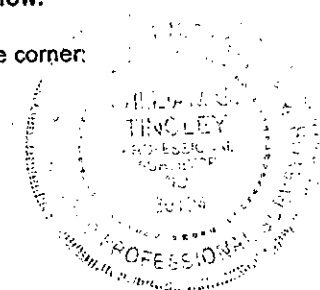

This corner is accepted as a careful and faithful perpetuation of the position of the original corner.

Signed by William Tingley Date 12-12-1995
Surveyor's Michigan License No. 30104

FORM APPROVED BY MICHIGAN STATE BOARD OF LAND SURVEYORS, JAN. 28, 1971
REVISED MAY 14, 1976
REVISED JAN, 1983
ADAPTED FOR WORD PROCESSING MARCH, 1983