

GRATIOT COUNTY REMONUMENTATION PROGRAM

FEB 22 1996

Corner approved by Peer Group on _____

GRATIOT CO. MICH.

RECORDED

COMMISSION

LAND CORNER RECORDATION CERTIFICATE

Filing Requirement of Act 74, Mich. P.A. 1970

'95 JAN 17 AM 11 48

For corners in

Gratiot
(County)

Located In:

Corner Code #

Janet M. Davis
REGISTER OF DEEDS

- 1. Public Land Survey Sec 31 T 11 R 2 C-12, E 1/4
T _____ R _____
T _____ R _____
T _____ R _____
- 2. Property Controlling S _____ T _____ R _____
in Section S _____ T _____ R _____
- 3. Miscellaneous S _____ T _____ R _____
Property in Sec. S _____ T _____ R _____
- 4. Lot No. _____ Recorded Plat _____
- 5. Private Claims _____

Register of Deeds Stamp & File Number

I, William Tingley a field survey on July 25, 1994

do hereby certify that under requirements of P.A. 74, Michigan P.A. of 1970, the corner points mentioned in lines 1 and 2 above were in conformance with regulations and rules therefore as required in the current manual of survey instructions of the United States Department of the Interior, Bureau of Land Management or by a decree of a Court of Law and/or that the corner points mentioned in lines 3, 4 and 5 above were in conformance with the rules of the Michigan Board of Land Surveyors or by a Decree of a Court of Law; established, re-established, monumented, re-monumented, recovered, found as expressed below:

NOTE: Not more than 4 corners, all in the same town and range, may be recorded on this certificate.

A. Description of original monument and accessories and/or subsequent restoration:

1831, R. Clark, Jr. Deputy Surveyor, GLO Notes

Set Post

Sugar 8" S68° W 22 links

Sugar 10" S37-1/2° E 21 links

Gratiot County Road Commission Record of Minutes of Survey, covering surveys by S.S. Hastings

1862, C.B. Fraker in 1867 and others since, dates not recorded

Post 2" x 4" Stones and crockery, no witnesses

January 1880, Thomas H. Harrod, Deputy County Surveyor, Liber B, Page 297

Cherry Post Corner 3" x 3"

Oak 12" S79° E 84 links

Old Corner Found

B. Description of corner evidence found and/or method applied in restoring or reestablishing corner:

Found 3/4" Iron Pipe over nest of stones 1 foot below surface

Located on occupation to North and West

ACCEPTED BY THE GRATIOT COUNTY SURVEY PEER GROUP AS THE OFFICIAL CORNER UNDER MICHIGAN PUBLIC ACT 345 OF 1890 AT A MEETING HELD Aug 5/1994

William Tingley
William Tingley, PS, Chairman

C. Description of monument for corner and accessories established to perpetuate locating the position of the corner:

Set Remonumentation Corner and Monument Box over 3/4" Iron Pipe and Stones

Easterly end guard rail post N30° E 14.44 feet

Westerly end guard rail post N20° W 19.89 feet

Railroad tie fence post N85° E 39.96 feet

Set Nail and Tag Westside Power Pole S20° E 91.05 feet


Set Nail and Tag 8" Elm S47° E 20.24 feet

Right of Way Fence (US-27) West 5 feet +/-

This corner is accepted as a careful and faithful perpetuation of the position of the original corner.

Signed by *William Tingley* Date August 5, 1994

Surveyor's Michigan License No. 30104

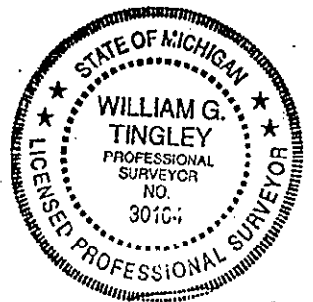

FORM APPROVED BY MICHIGAN STATE BOARD OF LAND SURVEYORS, JAN. 28, 1971. REVISED MAY 14, 1975. REVISED JAN., 1983. ADAPTED FOR WORD PROCESSING MARCH, 1993.

9/7 File