

**SURVEY & REMONUMENTATION**

**FEB 10 2000**

**GRATIOT COUNTY REMONUMENTATION PROGRAM**

**LAND CORNER RECORDATION CERTIFICATE**

**Filing Requirement of Act 74, Mich. P.A. 1970**

**LIBER 615 PAGE 1450**

**SECTION**

For corners in

Gratiot  
(County)

Located In:

Emerson Township

Corner Code #

- |                                    |                         |                |
|------------------------------------|-------------------------|----------------|
| 1. Public Land Survey              | Sec 35 T 11N R 2W       | K-13, S. Bndry |
|                                    | T _____ R _____         | _____          |
|                                    | T _____ R _____         | _____          |
|                                    | T _____ R _____         | _____          |
| 2. Property Controlling in Section | S _____ T _____ R _____ | _____          |
|                                    | S _____ T _____ R _____ | _____          |
| 3. Miscellaneous Property in Sec.  | S _____ T _____ R _____ | _____          |
|                                    | S _____ T _____ R _____ | _____          |
4. Lot No. \_\_\_\_\_, Recorded Plat \_\_\_\_\_
5. Private Claims \_\_\_\_\_

STATE OF MICHIGAN  
GRATIOT COUNTY  
RECORDED

29 OCT 99 12:11 P.M.

JANET N. DAVIS  
REGISTER OF DEEDS

Register of Deeds Stamp & File Number

I, William Tingley a field survey on December 4, 1995, do hereby certify that under requirements of P.A. 74, Michigan P.A. of 1970, the corner points mentioned in lines 1 and 2 above were in conformance with regulations and rules therefore as required in the current manual of survey instructions of the United States Department of the Interior, Bureau of Land Management or by a decree of a Court of Law and/or that the corner points mentioned in lines 3, 4 and 5 above were in conformance with the rules of the Michigan Board of Land Surveyors or by a Decree of a Court of Law; established, re-established, monumented, re-monumented, recovered, found as expressed below:

**NOTE: Not more than 2 corners, all in the same town and range, may be recorded on this certificate.**

A. Description of original monument and accessories and/or subsequent restoration:

1831, R. Clarke, Jr., Deputy Surveyor, GLO Notes

Set Post Corner, Sections 35 and 36

Maple 20" N71°E 34 links  
Beech 6" N57°W 19 links

1873, D.W. Aitenburg, County Surveyor Field Book 11-2

Old Corner Found

Beech 18" S40°E 108-1/2 links  
Maple 12" N40°E 104-1/2 links

1880, T.H. Harrod, Deputy Surveyor, Field Book, 11-2, Page 166 and 167

3" x 3" Ironwood and stone on top -- Old Corner found

Oak 24" S32°W 64 links

Liber B, page 298, Minutes of Survey

Same Record

1973, David Whittier, #10070, LCRC, Liber 1, Page 355

Found 2" x 2" Wood Post and Wire

Set 3/4" Pipe in Monument Box

Nail in Southwest Side of Power Pole Northwest 81.15 feet  
Nail in Eastside of Fence Post South 30.30 feet  
Southwest Corner Concrete Block Foundation of House Northeast 113.65 feet

1973, D.B. Whittier, Survey G1373

Same bearing trees as Liber 1, Page 355

B. Description of corner evidence found and/or method applied in restoring or reestablishing corner:

Found Monument Box with 3/4" x 2 foot iron pipe on Centerline of Pavement.

Dug 3.5 feet below surface. Found nothing further. Also dug a hole 4 feet North of Centerline of Pavement per old Road plans but found nothing there. Accepted Whittier's Corner.

C. Description of monument for corner and accessories established to perpetuate locating the position of the corner:

Set Remonumentation Monument over 3/4" Pipe in Monument Box

Found Nail and Tag #17741 Southwest Side of Power Pole N45°W 81.42 feet  
Easterly Leg of "Arrow Street Sign" South 21.17 feet  
Centerline 12" Maple N40°E 80.75 feet  
Southwest Corner House Foundation N45°E 113.65 feet

This corner is accepted as a careful and faithful perpetuation of the position of the original corner.

Signed by William G. Tingley Date 11/19/1997


Surveyor's Michigan License No. 30104

	A	B	C	D	E	F	G	H	I	J	K	L	M
1													
2		6	5	4	3	2	1						
3													
4		7	8	9	10	11	12						
5													
6		18	17	16	15	14	13						
7													
8		19	20	21	22	23	24						
9													
10		30	29	28	27	26	25						
11													
12		31	32	33	34	35	36						
13													

ACCEPTED BY THE MONTCALM COUNTY SURVEY PEER GROUP AS THE OFFICIAL CORNER UNDER MICHIGAN PUBLIC ACT 345 OF 1990 AT A MEETING HELD 11/19/97

WGT  
William Tingley, PS, Chairman

FORM APPROVED BY MICHIGAN BOARD OF LAND SURVEYORS, JAN. 28, 1971  
REVISED MAY 14, 1976  
REVISED JAN., 1983  
FOR WORD PROCESSING MARCH, 1993

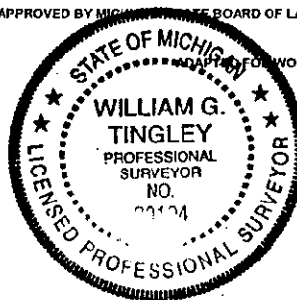

LIBER 3 PAGE 194