

**SURVEY &  
REMONUMENTATION**

**LIBER 578 PAGE 1001**

**APR 23 1998**

**GRATIOT COUNTY REMONUMENTATION PROGRAM GRATIOT CO. MICH.**

**LAND CORNER RECORDATION CERTIFICATE**

**RECORDED**

**SECTION**

**Filing Requirement of Act 74, Mich. P.A. 197697 DEC 29 AM 9 37**

For corners in  
Gratiot  
(County)

Located In: Corner Code #

*Janet M. Davis*  
REGISTER OF DEEDS

1. Public Land Survey	Sec 36	T 11N	R 2W	M-13, SE Corner
		T 11N	R 1W	A-13, SW Corner
		T	R	
		T	R	
2. Property Controlling in Section	S	T	R	
	S	T	R	
3. Miscellaneous Property in Sec.	S	T	R	
	S	T	R	

Register of Deeds Stamp & File Number

4. Lot No. \_\_\_\_\_ Recorded Plat \_\_\_\_\_  
5. Private Claims \_\_\_\_\_

I, William Tingley a field survey on January 15th, 1997, do hereby certify that under requirements of P.A. 74, Michigan P.A. of 1970, the corner points mentioned in lines 1 and 2 above were in conformance with regulations and rules therefore as required in the current manual of survey instructions of the United States Department of the Interior, Bureau of Land Management or by a decree of a Court of Law and/or that the corner points mentioned in lines 3, 4 and 5 above were in conformance with the rules of the Michigan Board of Land Surveyors or by a Decree of a Court of Law, established, re-established, monumented, re-monumented, recovered, found as expressed below:

A	B	C	D	E	F	G	H	I	J	K	L	M
2	6	5	4	3	2	1						
3												
4	7	8	9	10	11	12						
5												
6	18	17	16	15	14	13						
7												
8	19	20	21	22	23	24						
9												
10	30	29	28	27	26	25						
11												
12	31	32	33	34	35	36						
13												

NOTE: Not more than 2 corners, all in the same town and range, may be recorded on this certificate.

A. Description of original monument and accessories and/or subsequent restoration:

- 1831, Robert Clark, Jr., Deputy Surveyor, GLO Notes  
62.27 Chain; intersected line between Range 1 and 2 West at end of 5 miles, 79 chains, 55 links at 45 links South of temporary post  
80 chains Set Post Corner T11N- 1 and 2 West  
Elm 30" N54°E 35 links  
Beech 10" N50-1/2°W 43 links
- 1873, D.W. Altenburg, County Surveyor, Liber B, Page 117 and Field Book 11-2, Pages 168 and 169  
2" x 2" Post - old corner found  
Elm 10" N54-1/2°E 108 links  
Oak 36" S20°E 180-1/2 links
- 1882, D.W. Altenburg, County Surveyor, Field Book 11-2, page 168 and 169  
Stone Corner  
Norway Maple 2" Southeast 30.7 feet  
Norway Maple 2" Southwest 37.2 feet  
Fence Post Northeast 60.0 feet
- 1968, Field Book, 11-2, Page 168 - no surveyor shown  
Set Monument Box at Corner  
No date, County Road Commission records  
Monument Box  
Nail and Cap in Ash Northeast 43.88 feet  
Nail and Cap in Box Elder Northwest 31.95 feet
- 1975, D.B. Whittier, LCRC, Liber 1, Page 355  
Found pipe in monument box  
Nail and Tag in Telephone Pole N45°W 72.0 feet  
Nail and Tag in East side Telephones Pole S45°E 37 feet  
West Leg of Stop Sign Northeast 55.5 feet

ACCEPTED BY THE MONTCALM COUNTY SURVEY PEER GROUP AS THE OFFICIAL CORNER UNDER MICHIGAN PUBLIC ACT 345 OF 1890 AT A MEETING HELD 11/28/97


*W.G.T.*  
William Tingley, PS, Chairman

B. Description of corner evidence found and/or method applied in restoring or reestablishing corner:

Found 3/4" pipe in Monument Box at surface. At 1.5 feet +/- below surface, found a large stone with stones around

C. Description of monument for corner and accessories established to perpetuate locating the position of the corner:


- Set Remonumentation Monument over 3/4" Pipe in Monument Box.
- 16 d Spike in Westside Power Pole N40°W 72.21 feet
- 16 d Spike in Northside Power Pole S55°W 72.89 feet
- 16 d Spike in South side Power Pole S35°E 82.29 feet
- West Leg of Stop Sign N40°E 52.83 feet

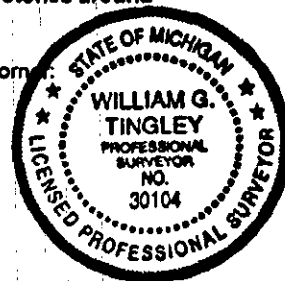

This corner is accepted as a careful and faithful perpetuation of the position of the original corner.

Signed by William G. Tingley Date 1/19

Surveyor's Michigan License No. 30104

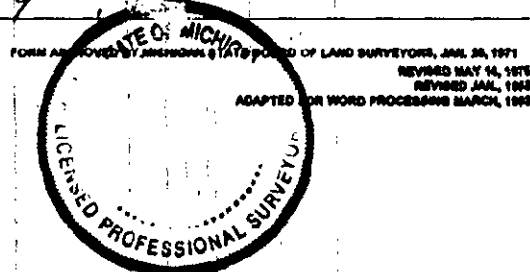

File 1/19