

AUG 3 1 1994

Corner approved by Peer Group on _____, 1994

COMMISSION

LAND CORNER RECORDATION CERTIFICATE

Filing Requirement of Act 74, Mich. P.A. 1970

GRATIOT CO. MICH. RECORDED

'94 AUG 19 AM 10 09

Janet M. Davis REGISTER OF DEEDS

Register of Deeds Stamp & File Number

For corners in Gratiot (County)

Located In: Corner Code #

1. Public Land Survey Sec 19 T 11 R 3 B-9, S 1/4

2. Property Controlling in Section S _____ T _____ R _____

3. Miscellaneous Property in Sec. S _____ T _____ R _____

4. Lot No. _____ Recorded Plat _____

5. Private Claims _____

	A	B	C	D	E	F	G	H	I	J	K	L	M
1													
2	6		5		4		3		2		1		
3													
4	7		8		9		10		11		12		
5													
6	18		17		16		15		14		13		
7													
8	19		20		21		22		23		24		
9													
10	30		29		28		27		26		25		
11													
12	31		32		33		34		35		36		
13													

I, William Tingley a field survey on July 26, 1994, do hereby certify that under requirements of P.A. 74, Michigan P.A. of 1970, the corner points mentioned in lines 1 and 2 above were in conformance with regulations and rules therefore as required in the current manual of survey instructions of the United States Department of the Interior, Bureau of Land Management or by a decree of a Court of Law and/or that the corner points mentioned in lines 3, 4 and 5 above were in conformance with the rules of the Michigan Board of Land Surveyors or by a Decree of a Court of Law; established, re-established, monumented, re-monumented, recovered, found as expressed below:

NOTE: Not more than 4 corners, all in the same town and range, may be recorded on this certificate.

A. Description of original monument and accessories and/or subsequent restoration:


GLO Notes
 Set Post
 Elm 12" N09°W 17 links
 White Maple 10" S14°W 15 links
 September, 1893, D.W. Attenburg, County Surveyor Liber C, Page 202
 Piece Iron Sleigh Shoe
 Elm 14" S21-1/2°W 60 links
 Old 1/4 Post found
 October, 1893, D.W. Attenburg, County Surveyor, Liber C, Page 204
 Same as above.

B. Description of corner evidence found and/or method applied in restoring or reestablishing corner:

Found Sleigh Shoe broken in four pieces, drove around wood stake.
 Accepted wood stake as corner.

C. Description of monument for corner and accessories established to perpetuate locating the position of the corner:

Set Remonumentation Corner over Wood Stake.
 Found Nail and Tag Southside 8" Basswood N45°W 37.18 feet
 Set Nail and Tag 10" Elm N5°W 18.97 feet
 Pipeline Marker S52°W 44.92 feet
 Found Cap & Iron #21567 North 33.21 feet
 Face of 4" Steel Pipeline Marker N18°E 24.58 feet
 Centerline of East-West Road (Polk Road) South 4.5 feet

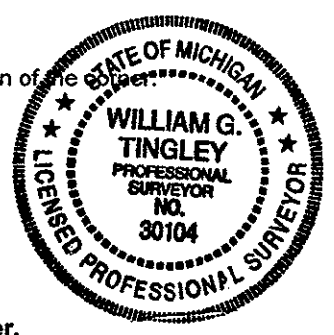

This corner is accepted as a careful and faithful perpetuation of the position of the original corner.

Signed by William Tingley Date 5 Aug 1994

Surveyor's Michigan License No. 30104

FORM APPROVED BY MICHIGAN STATE BOARD OF LAND SURVEYORS, JAN. 28, 1971
 REVISED MAY 14, 1976
 REVISED JAN., 1983
 ADAPTED FOR WORD PROCESSING MARCH, 1993

ACCEPTED BY THE GRATIOT COUNTY SURVEY PEER GROUP AS THE OFFICIAL CORNER UNDER MICHIGAN PUBLIC ST 365 OF 1984 AT AMBERFIELD
5 Aug 94
William Tingley
 William Tingley, P.S., Chairman