

FEB 22 1996 GRATIOT COUNTY REMONUMENTATION PROGRAM
LAND CORNER RECORDATION CERTIFICATE
COMMISSION Filing Requirement of Act 74, Mich. P.A. 1970

GRATIOT CO. MICH.
RECORDED

'95 DEC 20 PM 1 27

Janet M. Davis
REGISTER OF DEEDS

For corners in
Gratiot
(County)

Located In: Emerson Twonship

Corner Code #

1. Public Land Survey Sec 1 T 11 N R 3 W M-3, Sec. Cor
 T _____ R _____
 T _____ R _____
 T _____ R _____

2. Property Controlling S _____ T _____ R _____
 in Section S _____ T _____ R _____

3. Miscellaneous S _____ T _____ R _____
 Property in Sec. S _____ T _____ R _____

Register of Deeds Stamp & File Number

4. Lot No. _____, Recorded Plat _____

5. Private Claims _____

	A	B	C	D	E	F	G	H	I	J	K	L	M
1													
2	6	5	4	3	2	1							
3													
4	7	8	9	10	11	12							
5													
6	18	17	16	15	14	13							
7													
8	19	20	21	22	23	24							
9													
10	30	29	28	27	26	25							
11													
12	31	32	33	34	35	36							
13													


I, William Tingley a field surveyor on September 20, 1995, do hereby certify that under requirements of P.A. 74, Michigan P.A. of 1970, the corner points mentioned in lines 1 and 2 above were in conformance with regulations and rules therefore as required in the current manual of survey instructions of the United States Department of the Interior, Bureau of Land Management or by a decree of a Court of Law and/or that the corner points mentioned in lines 3, 4 and 5 above were in conformance with the rules of the Michigan Board of Land Surveyors or by a Decree of a Court of Law; established, re-established, monumented, re-monumented, recovered, found as expressed below:

NOTE: Not more than 4 corners, all in the same town and range, may be recorded on this certificate.

- A. Description of original monument and accessories and/or subsequent restoration:
- 1831, Robert Clark, Jr., Deputy Surveyor, GLO Notes
Set Post Corner, Sections 1 and 12
Beech 13" S48-1/4°W 65 links
Beech 11" N67°W 22 links
 - 1897, J.W. Harrod, County Surveyor
Old Corner (2" pipe in box)
Elm 14" Southwest 69 links
Maple Southwest 58.4 feet
Double Maple Northwest 41.7 feet
 - 1961, Michigan State Highway Department plans using 1931 construction data. Section corner Arcada Township.
Station 237 +68.9 feet; Emerson Township Corner 237 +74.3
 - 1970, Merrill Hunter in Survey #G-626
Shows Monument box on Corner Sections 6 and 7 T11N-R2W, 5.4 feet North of Corner 1 and 12 T11N-R3W
 - 1995, Gratiot County Road Commission, Plans Federal Project, Station 160+10
Monument Box in Center of Road-Section Corner

B. Description of corner evidence found and/or method applied in restoring or reestablishing corner:
Found 3/8" Rod in Monument Box, nothing below, raised with 1/2" pipe in Monument Box. On centerline gravel road to West. South of corner 6 and 7 T11N-R2W, 5.40 feet.

- C. Description of monument for corner and accessories established to perpetuate locating the position of the corner:
- Set Remonumentation Corner over 1/2" Pipe in Monument Box
 - Centerline Cable Box N45°W 63.39 feet
 - Centerline North Telephone Box S45°W 56.07 feet
 - Southwest Corner Concrete Gutter N70°E 69.88 feet
 - Southwest Corner Concrete Gutter S30°E 56.56 feet
 - Corner of 6 & 7, 11-2 (A-3) North 5.40 feet

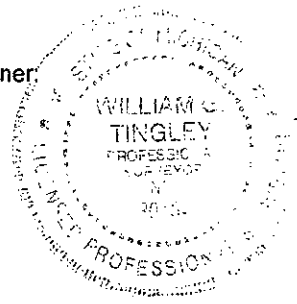

This corner is accepted as a careful and faithful perpetuation of the position of the original corner.

Signed by William Tingley Date 12-22, 1995
Surveyor's Michigan License No. 30104

FORM APPROVED BY MICHIGAN STATE BOARD OF LAND SURVEYORS, JAN. 28, 1971
REVISED MAY 14, 1975
REVISED JAN., 1983
ADAPTED FOR WORD PROCESSING MARCH, 1985

ACCEPTED BY THE GRATIOT COUNTY SURVEY PEER GROUP AS THE OFFICIAL CORNER UNDER MICHIGAN PUBLIC ACT 345 OF 1990 AT A MEETING HELD 11-29-95

William Tingley
William Tingley, PS, Chairman