

FEB 22 1996

GRATIOT COUNTY REMONUMENTATION PROGRAM
LAND CORNER RECORDATION CERTIFICATE
Filing Requirement of Act 74, Mich. P.A. 1970

GRATIOT CO. MICH.
RECORDED
'95 DEC 20 PM 1 27

Form with fields for 'or corners in Gratiot (County)', Located in: Arcada Township, Corner Code #, Public Land Survey, Property Controlling in Section, Miscellaneous Property in Sec.

Janet M. Davis
REGISTER OF DEEDS

Register of Deeds Stamp & File Number

Lot No., Recorded Plat, Private Claims

Grid table with columns A-M and rows 1-13 containing numbers 1-36.

William Tingley a field survey on October 5, 1995. Do hereby certify that under requirements of P.A. 74, Michigan P.A. of 1970, the corner points mentioned in lines 1 and 2 above were in conformance with regulations and rules therefore as required in the current manual of survey instructions of the United States Department of the Interior, Bureau of Land Management or by a decree of a Court of Law and/or that the corner points mentioned in lines 3, 4 and 5 above were in conformance with the rules of the Michigan Board of Land Surveyors or by a Decree of a Court of Law; established, re-established, monumented, re-monumented, recovered, found as expressed below:

NOTE: Not more than 4 corners, all in the same town and range, may be recorded on this certificate.

A. Description of original monument and accessories and/or subsequent restoration:

- 1831, Robert Clark, Jr. Deputy Surveyor, GLO Notes
Set Post Corner Section 24 and 25
1880, T.H. Harrod, county Surveyor
Oak Post and Plow Point
Elm 14" N72-1/2°E 123-1/2 links
Apple 4" N53°W 101 links
66 links South of Corner 19-30 T11N-R2W
1961, Michigan State Highway Department plans (resurfacing) using 1931 construction plans, Arcada Township corner, Station 79 +14.84, Emerson Township Corner Station 79 + 58.4
1976, D.E. Hunter, #19177, Survey, Liber 406, page 767
Monument not described
Spike in Power Pole N45°E 100.92 feet
Spike in Power Pole N30°W 81.90 feet
Spike in Telephone Pole S45°W 47.74 feet
1990, W.B. Ruddell, #14769, Survey, Liber 498, Page 925
Set a spike and cap
Nail and Cap in North fence braces Post North Northwest 98.25 feet
Nail and Cap in Pole Southwest 48.20 feet
Michigan State Highway Department Tag in Pole North Northwest 82.05 feet
Top Center, Catch Basin Dome Northwest 37.10 feet
1992, P. Lapham #9433, LCRC, Liber 2, Page 288
Found Nail and Tag
Power Pole N45°E 100.92 feet
Telephone Pole S45°W 47.75 feet
Nail & Tag in Power Pole N45°E 91.38 feet
5" Elm S55°E 75.40 feet

ACCEPTED BY THE GRATIOT COUNTY SURVEY PEER GROUP AS THE OFFICIAL CORNER UNDER MICHIGAN PUBLIC ACT 345 OF 1990 AT A MEETING HELD 11/29/95


William Tingley, PS, Chairman

1995, Gratiot County Road Commission, Federal Project MSTP 9529 (002), Station 2+00, Section Corner 43.56 feet South of Section Corner 19 and 30 T11N-R2W, Monument Box with 1" Pipe

B. Description of corner evidence found and/or method applied in restoring or reestablishing corner: Set Corner 43.56 South Emerson Township Corner on Centerline Polk Road and State Road which matches witnesses by Ruddell and Lapham. Set on standard township line.

C. Description of monument for corner and accessories established to perpetuate locating the position of the corner:

- Set Remonumentation Monument 43.56 feet South of Section Corner 19 and 30 in Monument Box
Centerline North-South Pavement
Found Michigan State Highway Department in Power Pole N40°W 82.25 feet
Found Nail/Brass Tag in Power Pole N45°E 91.50 feet
Found Nail and #14769 Tag in Power Pole S45°W 48.20 feet
Set Nail and Tag in 7" Maple S45°E 75.45 feet

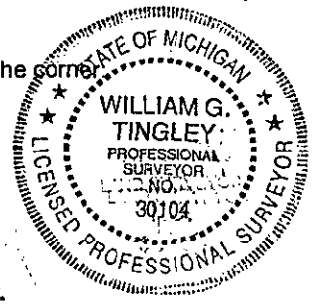

This corner is accepted as a careful and faithful reestablishment of the position of the original corner.

Signed by William G. Tingley Date 12-12-1995

Surveyor's Michigan License No. 30104