

SURVEY & REMONUMENTATION COMMISSION

GRATIOT COUNTY REMONUMENTATION PROGRAM

LIBER **538** PAGE **504**
1994

AUG 31 1994

Corner approved by Peer Group on 5 Aug

LAND CORNER RECORDATION CERTIFICATE

Filing Requirement of Act 74, Mich. P.A. 1970

GRATIOT CO. MICH.
RECORDED

'94 AUG 19 AM 10 08

Janet M. Davis
REGISTER OF DEEDS

Register of Deeds Stamp & File Number

For corners in Gratiot Located in: _____ Corner Code # _____
(County)

1. Public Land Survey Sec 6 T 11 R 4 A-3, SW Corner

 T _____ R _____
 T _____ R _____
 T _____ R _____

2. Property Controlling S _____ T _____ R _____
 in Section S _____ T _____ R _____

3. Miscellaneous S _____ T _____ R _____
 Property in Sec. S _____ T _____ R _____

4. Lot No. _____, Recorded Plat _____

5. Private Claims _____

	A	B	C	D	E	F	G	H	I	J	K	L	M
1													
2	6			5			4			3		2	1
3													
4	7			8			9			10		11	12
5													
6	18			17			16			15		14	13
7													
8	19			20			21			22		23	24
9													
10	30			29			28			27		26	25
11													
12	31			32			33			34		35	36
13													

I, William Tingley a field survey on July 26, 1994, do hereby certify that under requirements of P.A. 74, Michigan P.A. of 1970, the corner points mentioned in lines 1 and 2 above were in conformance with regulations and rules therefore as required in the current manual of survey instructions of the United States Department of the Interior, Bureau of Land Management or by a decree of a Court of Law and/or that the corner points mentioned in lines 3, 4 and 5 above were in conformance with the rules of the Michigan Board of Land Surveyors or by a Decree of a Court of Law; established, re-established, monumented, re-monumented, recovered, found as expressed below:

NOTE: Not more than 4 corners, all in the same town and range, may be recorded on this certificate.

A. Description of original monument and accessories and/or subsequent restoration:
 May 4, 1831, R. Clark, Jr. Deputy Surveyor, GLO Notes

Set Post
 Beech 8" S56°W 50 links
 Elm 7" N20°W 7 links

May, 1879, S.S. Hastings, County Surveyor, Liber C, Page 29
 Long Stone with Stone around it (Old Corner)

May 1947, no name given, Gratiot County Road Commission, Record of Minutes of Survey
 Found Stone

Set Pipe 3/4" x 36" at Westside of stone Montcalm Corner South 108.85 feet
 Center of Elm 6" North 20° +1-E 91.2 feet
 East Gate Post (10" Cedar) South 148.3 feet
 Center 7" Elm N70°+1-E 59.1 feet

October, 1978, Jerry L. Jones #19838, recorded survey, Liber 417, Page 604

Found 3/4" Pipe, large stone
 Southwest to telephone cable sign 39.0 feet
 West edge of Road in line with Road to East
 Southeast to Road sign 79.0 feet

November 1978, Jerry L. Jones #19838, LCRC, Liber 1, Page 444

Same as above.

May, 1985, Jan S. Fokens #21567, Recorded Survey, Liber 469, Page 892

Found 3/4" Pipe
 Nail and Tag Elm 4" N10°W 41.4 feet
 Nail and Tag Elm 5" N80°W 18.60 feet
 Jog Corner South 108.60 feet

B. Description of corner evidence found and/or method applied in restoring or reestablishing corner:

Found 1/2" Square Bolt Spike 1.0 foot long set on Westside of pointed stone

Found 3/4" Iron Pipe Horizontal on Eastside of stone

Stone is 2.8 feet long, 6" square on bottom, 4" square on top


Found 1-1/4" Iron Pipe South 108.7 feet

Found Nail & Tag Service Pole S45°E 171.55 feet Continued on back

C. Description of monument for corner and accessories established to perpetuate locating the position of the corner:

Set Remonumentation Corner and Monument Box over pipe next to stone

East end culvert N35°E 48.65 feet
 Set Nail & Tag Northeast side power pole N30°W 77.52 feet
 Found 1-1/4" Iron Pipe South 108.7 feet
 Set Nail & Tag West side 12" Elm N15°E 162.27 feet
 Found Nail & Tag Service Pole S45°E 171.55 feet

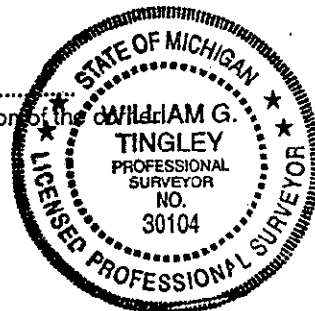

Signed by William Tingley Date 5 Aug 1994

Surveyor's Michigan License No. 30104

April 1990, William B. Ruddell, #14769, Recorded Survey, Liber 495, Page 366

Found 3/4" Pipe

Telephone Cable Sign	Southwest	39.0 feet
Nail and Tag in Pole	North-Northeast	76.75 feet
Nail and Tag in 8" Box Elder	South	106.47 feet
Nail and Tag in Pole	Southeast	171.55 feet
Capped "T" Iron	Southeast	128.25 feet