

1993

COMMISSION

LAND CORNER RECORDATION CERTIFICATE

Filing Requirement of Act 74, Mich. P.A. 1970
Gratiot County Remonumentation Program

GRATIOT CO. MICH.
RECORDED

'93 DEC 20 PM 12 24

Janet M. Davis
REGISTER OF DEEDS

Register of Deeds Stamp & File Number

For corners in GRATIOT (County) Located In: Corner Code #
1. Public Land Survey Sec. 32 T 11 R 4 D-13 S 1/4
2. Property Controlling in Section S T R
3. Miscellaneous Property in Sec. S T R

4. Lot No. Recorded Plat
5. Private Claims

I, William Tingley a field survey on October 15, 1993, do hereby certify that under requirements of P.A. 74, Michigan P.A. of 1970, the corner points mentioned in lines 1 and 2 above were in conformance with regulations and rules therefore as required in the current manual of survey instructions of the United States Department of the Interior, Bureau of Land Management or by a decree of a Court of Law and/or that the corner points mentioned in lines 3, 4 and 5 above were in conformance with the rules of the Michigan Board of Land Surveyors or by a Decree of a Court of Law; established, re-established, monumented, re-monumented, recovered, found as expressed below:

NOTE: Not more than 4 corners, all in the same town and range, may be recorded on this certificate.

A. Description of original monument and accessories and/or subsequent restoration:

April 20, 1831 R. Clark, Jr., Deputy Surveyor
Set Quarter Section post T11N R4W
Elm 13" N80°E 13 links
Black Ash 8" N37°W 24 links

March 12, 13, 14, 1888, D.W. Altenburg, County Surveyor, Book C, Page 148 from Record of Minutes of Survey of Gratiot County Drain Commission

Found old quarter post
Set 1-1/2" Pipe as corner
Elm 24" S79°W 219.0 links
Trans Pole S70°30'E 204.0 links
Pole S50°W 134.3 links

July 2, 1981, John Nelson #21273, Liber 2, Page 31 of Land Corner Recordation Book

Found 1-1/2" Pipe 0.5' below surface of asphalt
State Plane Coordinates x = 1,871,550.46 y = 653,499.98
Nail and Tag in Southeast side of Telephone Pole N28°E 60.45'
Nail and Tag in Northeast side of Power Pole S78°E 204.55'
Nail and Tag in Northwest side of Power Pole S44°W 134.96'
Nail and Tag in East side of Power Pole N11°W 147.93'


B. Description of corner evidence found and/or method applied in restoring or reestablishing corner:

Accepted as corner. Found 1-1/2" iron pipe below 5/8" Rerod, Cap #21273 by John Nelson, #21273 Liber 2, Page 31 of Land Corner Recordation Book.

C. Description of monument for corner and accessories established to perpetuate locating the position of the corner:

Set remonumentation corner in mon box North of Centerline County Road 555.
Northeast Corner Section 6 T10N R4W West 238.92'
Nail and Tag Eastside Power Pole N11°W 147.93'
Nail and Tag Northwest side Power Pole S44°W 134.96'
Nail and Tag Northeast side Power Pole S78°E 204.55'
Nail and tag Southeast side Telephone Pole N28°E 60.45'

This corner is accepted as a careful and faithful perpetuation of the position of the original corner.

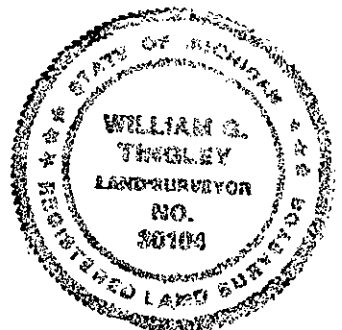

Signed by William G. Tingley Date November 30, 1993
Surveyor's Michigan License No. 30104