

FEB 22 1996

GRATIOT COUNTY REMONUMENTATION PROGRAM

LAND CORNER RECORDATION CERTIFICATE

Filing Requirement of Act 74, Mich. P.A. 1970

GRATIOT CO. MICH.
RECORDED

'95 DEC 20 PM 1 28

Janet M. Davis
REGISTER OF DEEDS

or corners in
Gratiot
(County)

Located In: Sumner Township

Corner Code #

Public Land Survey Sec 9 T 11 NR 4 W F-5, 1/4 Corner

T R

T R

T R

Property Controlling S T R

in Section S T R

Miscellaneous S T R

Property in Sec. S T R

Register of Deeds Stamp & File Number

Lot No. _____, Recorded Plat _____

Private Claims _____

William Tingley a field survey on October 3, 1995.

do hereby certify that under requirements of P.A. 74, Michigan P.A. of 1970, the corner points mentioned in lines 1 and 2 above were in conformance with regulations and rules therefore as required in the current manual of survey instructions of the United States Department of the Interior, Bureau of Land Management or by a decree of a Court of Law and/or that the corner points mentioned in lines 3, 4 and 5 above were in conformance with the rules of the Michigan Board of Land Surveyors or by a Decree of a Court of Law; established, re-established, monumented, re-monumented, recovered, found as expressed below:

	A	B	C	D	E	F	G	H	I	J	K	L	M
1													
2	6	5	4	3	2	1							
3													
4	7	8	9	10	11	12							
5													
6	18	17	16	15	14	13							
7													
8	19	20	21	22	23	24							
9													
10	30	29	28	27	26	25							
11													
12	31	32	33	34	35	36							
13													

NOTE: Not more than 4 corners, all in the same town and range, may be recorded on this certificate.

A. Description of original monument and accessories and/or subsequent restoration:

832, Orange Risdon, Deputy Surveyor, GLO Notes

Set 1/4 Section Post

Beech 12" North 21 links
Maple 12" S12° (No bearing or distance given)

October 1878, R.J. Fraker, County Surveyor, Liber B, Page 271, Record of Minutes of Survey in Gratiot

County Drain Commissioner's Office

Pine Stump 40" N17-1/2°W 121-3/4 links
Pine Stump 24" S 1/2°W 51 links

ACCEPTED BY THE GRATIOT COUNTY SURVEY PEER GROUP AS THE OFFICIAL CORNER UNDER MICHIGAN PUBLIC ACT 345 OF 1990 AT A MEETING HELD 11-29-95

879, S.S. Hastings, County Surveyor in Field Book 11-4, Page 100-101

Old Corner Found

Post set deep with stone
Pine Stump South 50-1/2 links

Liber C, Page 35, Record of Minutes of Survey, Gratiot County Drain Commissioner's Office

Same as 1879 record above

992, Gratiot County Road Commission

Found large semi-pointed black stone, with smaller stones
Found 3/4" pipe with Hunter/Whittier cap South of stone
South face 2" Pipe Anchor Post North 23.20 feet

B. Description of corner evidence found and/or method applied in restoring or reestablishing corner:


Tree Rows North and on Centerline Harrison Road found "black" stone with iron on South side

C. Description of monument for corner and accessories established to perpetuate locating the position of the corner:

Set Remonumentation Monument in Monument Box over stone

Top Centerline East End 15" CMP Culvert N45°E 41.40 feet
Top Centerline West End 15" CMP Culvert N25°E 29.30 feet
Traffic Sign Post N25°W 26.30 feet
Nail and Brass Tag in Westside 10" Box Elder North 54.00 feet

This corner is accepted as a careful and faithful perpetuation of the position of the original corner.

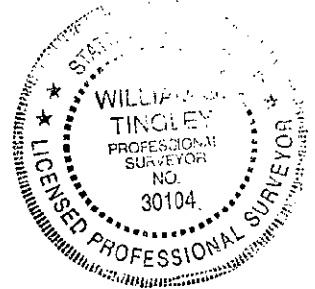

Signed by William Tingley Date 12-12-1995

Surveyor's Michigan License No. 30104